

Name Cyril Seymour

Service No. 115

Address 6 PAUL REVERE RD.

Location

Comm. 10-28-57

Kind of Pipe

Size 6"

Size of Main

~~Renewal~~—New Service

Location

Date	Material	Amount	Total	Date	Amount	
2-4-57	Labor	138.76		8-13-57	Deposit	\$ 200.00
	10% O.H.	13.88	152.64	11-13-57	Paid	28.62
	56' 6" Transite @.70		39.20			228.62
	1 11 1/2" Transite Bend		5.10			
	1 Blasting Cap		.18			
	1 Stick Dynamite		.25			
	4 hrs. Town Shovel		26.00			
	3 hrs. Trucking @.75		2.25			
	1 hr. Compressor @ 3.00		3.00			
			<u>228.62</u>			
	Labor					




DATE \_\_\_\_\_

# TOWN OF LEXINGTON — BOARD OF PUBLIC WORKS

## SEWER DIVISION

Sketch of Service Here

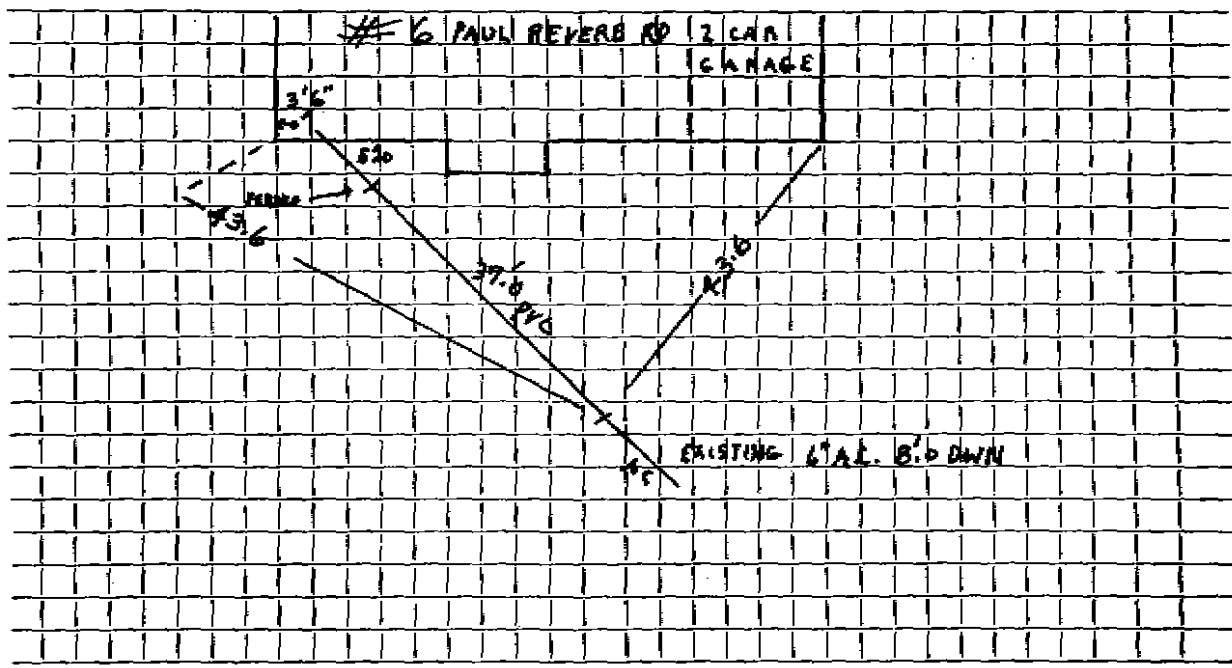

Connection made in ..... Street. Work completed .....

Remarks: .....  
.....  
.....

# TOWN OF LEXINGTON—DEPT. OF PUBLIC WORKS

## SEWER DIVISION

DATE.....

NO.....

The undersigned applies for the construction of a particular sewer connecting No.....  
 Street and hereby agrees to comply with the Rules and Regulations governing the construction and use of Particular  
 Sewers, as now or at any future time established by the Board of Selectmen.


Am't of estimate \$.....

Am't Paid \$.....

..... Owner

Sketch of Service Here

**6**

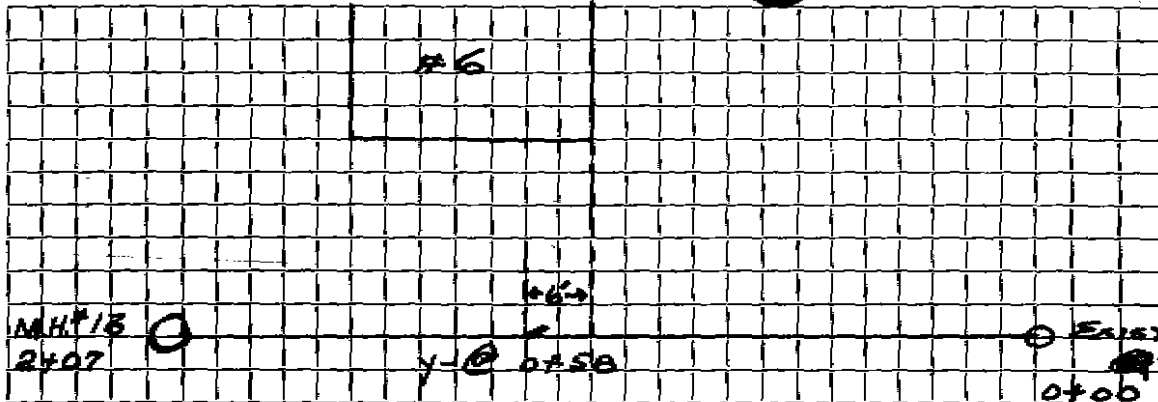

Connection made in..... Street.

Work completed.....19...

Remarks: