

Name I.W. Douglas

Service No. 147

Address 60 Paul Revere Road

60 Paul Revere Road

Location

Kind of Pipe

Size 6"

Size of Main 8"

~~Replaced~~ — New Service

Location Comm 12-8-58

Date	Material	Amount	Total	Date		Amount
12/58	Lab or	89 78		8-27-58	Deposit	200 00
	10% Overhead	8 98	98 76	10-8-58	Retund	2 66
	57'-6" Transite Pipe @ .70		39 90			197 34
	2-11 1/4 Bends Transite @ 5.10		10 20			
	2-22 1/2 Elbows @ 2.24		4 48			
	10 x 3 Patch		10 00			
	5 hrs. Town Shovel @ 6.50		32 50			
	2 hrs. Trucking @ .75		1 50			
			197 34			
	Labor					

TOWN OF LEXINGTON—DEPT. OF PUBLIC WORKS
SEWER DIVISION

DATE.....

NO.


The undersigned applies for the construction of a particular sewer connecting No.....
Street and hereby agrees to comply with the Rules and Regulations governing the construction and use of Particular
Sewers, as now or at any future time established by the Board of Selectmen.

Am't of estimate \$.....

Am't Paid \$.....

..... Owner

Sketch of Service Here **60**

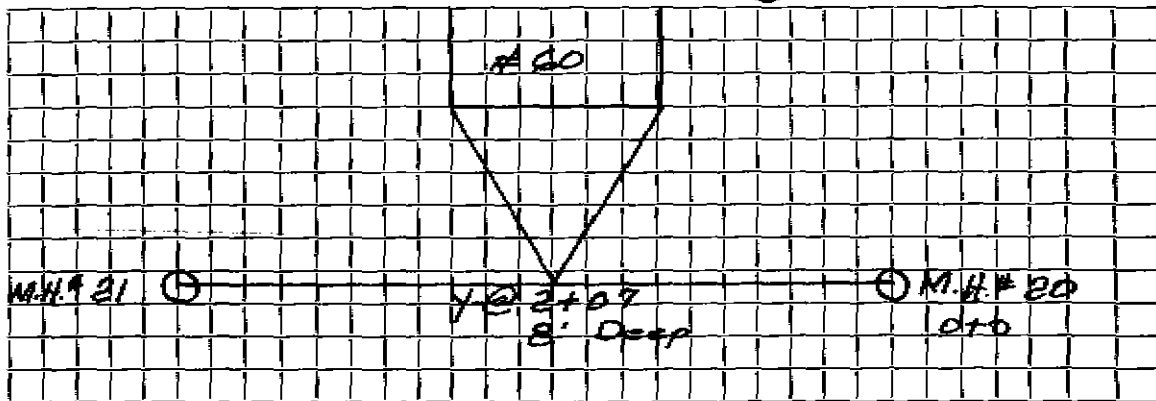

Connection made in..... Street.

Work completed..... 19..

Remarks: