

Name **Georg e Sullivan**Service No. **28**Address **64 Paul Revere Road****64 Paul Revere Road**

Location

Kind of Pipe

Size **6"**Size of Main **8"**~~REPAIR WORK~~ **New Service**Location **Comm 5-9-60**

Date	Material	Amount	Total	Date	Amount
-11-60	Labor 74.40			4-5-60	Deposit 200.00
-15-60	" 13.15	87.55		5-9-60	Refund 12.73
	10% O.H.	8.76	96.31		187.27
60'	6" Transite pipe @.78		46.80		
4	Sticks Dynamite @.26		1.04		
4	Blasting Caps @.28		1.12		
3	hrs. Insley Shovel @6.50		19.50		
2	hrs. Trucking @.75		1.50		
1	hr. Compressor @3.00		3.00		
1	hr. Trojan Loader @3.00		3.00		
1	hr. Trucking @3.00		3.00		
12	x 3 Patch		12.00		
	Labor		187.27		

# TOWN OF LEXINGTON—DEPT. OF PUBLIC WORKS

## SEWER DIVISION

DATE.....

NO. ....

The undersigned applies for the construction of a particular sewer connecting No.....  
 Street and hereby agrees to comply with the Rules and Regulations governing the construction and use of Particular  
 Sewers, as now or at any future time established by the Board of Selectmen.


Am't of estimate \$.....

Am't Paid \$.....

..... Owner

Sketch of Service Here

**69**

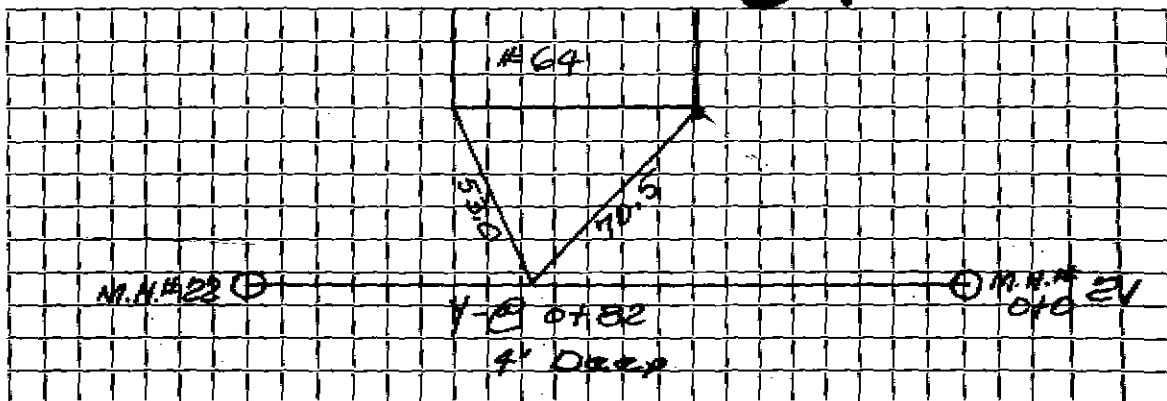

Connection made in..... Street.

Work completed.....19..

Remarks: