


TOWN OF LEXINGTON — BOARD OF PUBLIC WORKS

SEWER DIVISION

DATE _____

Sketch of Service Here **67**

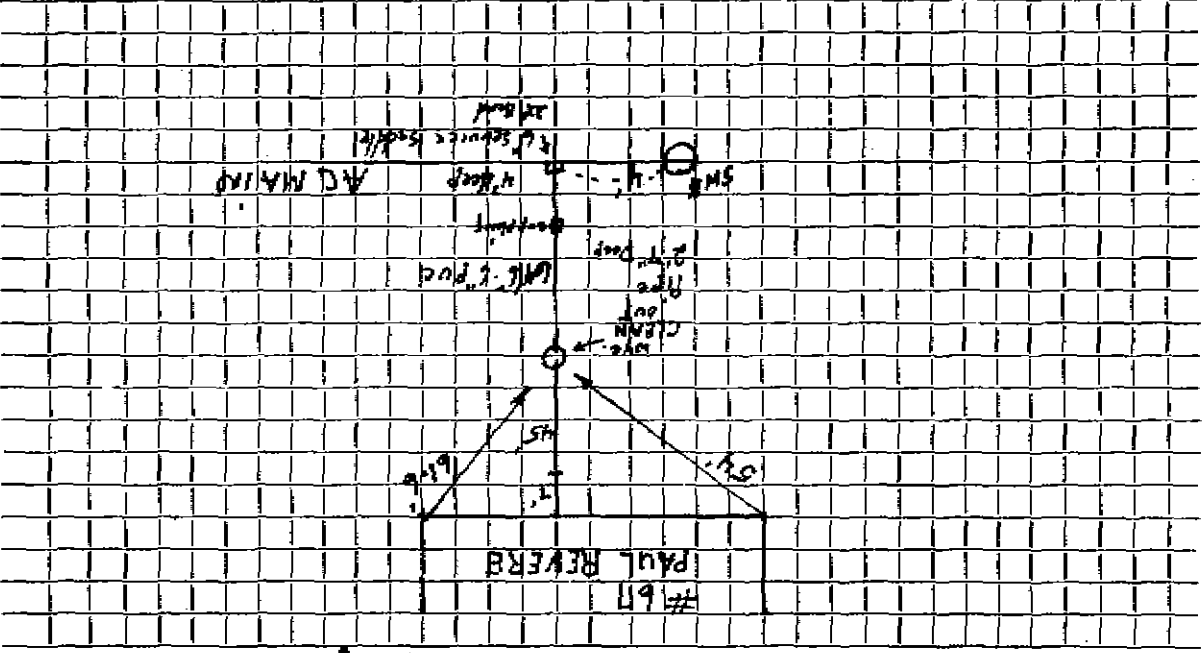

Street. Work completed

Connection made in

Remarks: SEWER OVER LATER MAIN