

Name Edward Steimen

Service No. 121

Address 68 Paul Revere Road

68 Paul Revere Road

Location

Kind of Pipe

Size 6"

Size of Main 8"

~~REWORK~~—New Service

Location Ann 12-4-61

Date	Material	Amount	Total	Date	Amount
1/26/61	Labor	70 12		9-13-61	Deposit 200 00
1/27/61	"	37 74		1-5-62	Paid 15 99
	10% O.H.	107.86 10 78	118 65		215 99
	53' 6" Transite Pipe @ .78		41 34		
	7 Hrs. Pippin Shovel @ 5.00		35 00		
	4 Hrs. Trucking @ 3.00		12 00		
	9 X 3 Patch		9 00		
			215 99		
	Labor				

Bill sent 1599

**TOWN OF LEXINGTON—DEPT. OF PUBLIC WORKS**  
**SEWER DIVISION**

DATE.....

NO. ....


The undersigned applies for the construction of a particular sewer connecting No.....  
 Street and hereby agrees to comply with the Rules and Regulations governing the construction and use of Particular  
 Sewers, as now or at any future time established by the Board of Selectmen.

Am't of estimate \$. .....

Am't Paid \$. .....

..... Owner

Sketch of Service Here **68**

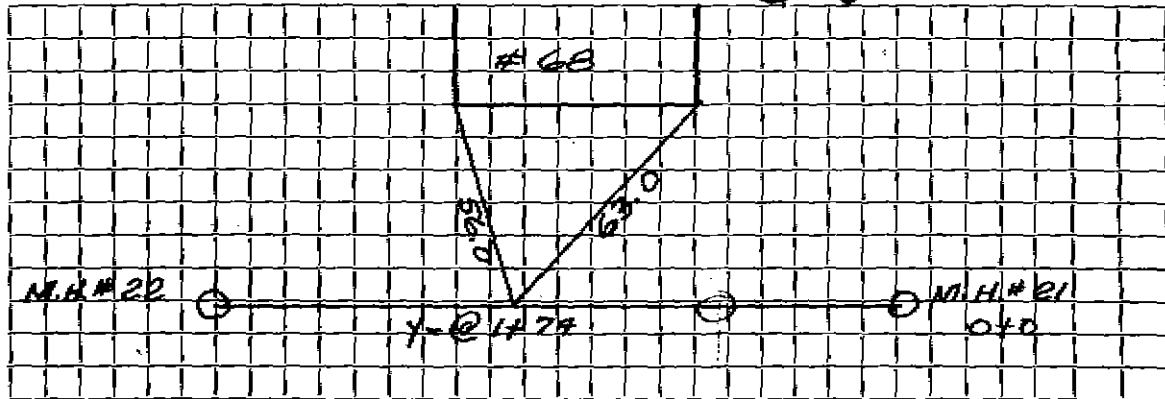

Connection made in..... Street.

Work completed.....19..

Remarks: