

Name

Andy Barnes

Service No.

Address

69 Paul Revere Rd.

69 Paul Revere Road

Location

Kind of Pipe

Size 6"

Size of Main 8"

Repair

Renewal - New Service Vokri 0302

Location

Date

4/29/93

Material

3.5 LF 4" PVC  
2- 4'x4' PERNO  
4'x4" W/VE CO.

Amount

Total

Date


Amount

TOWN OF LEXINGTON — BOARD OF PUBLIC WORKS

SEWER DIVISION

DATE 1/6/94

Sketch of Service Here **69**

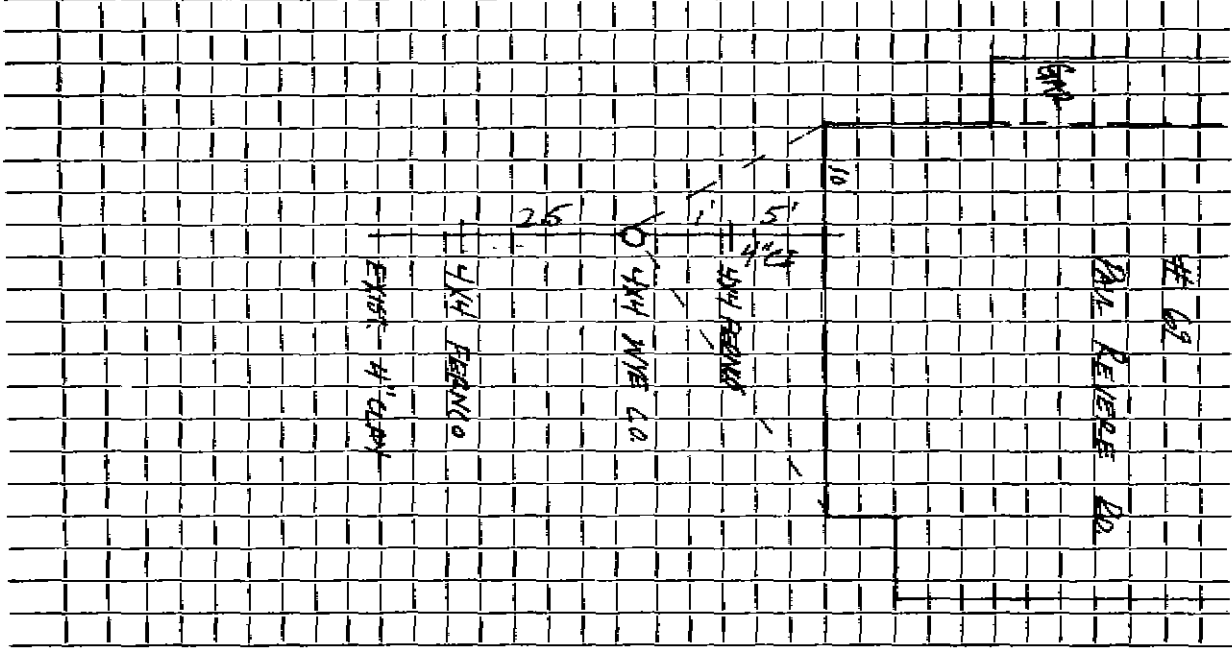

Connection made in Street. Work completed 11/29/93

Remarks: