

Name

George E. Doughty, Jr.

Service No.

Address # 75 PAUL REVERE RD.

Location

Kind of Pipe PVC

Size 6"

Size of Main

Repair - Removal - New Service Valeri #0634

Location


Date	Material	Amount	Total	Date	Amount
9/22	40 L.F. 6" PVC				
	6" X 6" FERNCO				
	4" X 6" "				

DATE 9/22/92

TOWN OF LEXINGTON — BOARD OF PUBLIC WORKS

SEWER DIVISION

Sketch of Service Here **75**

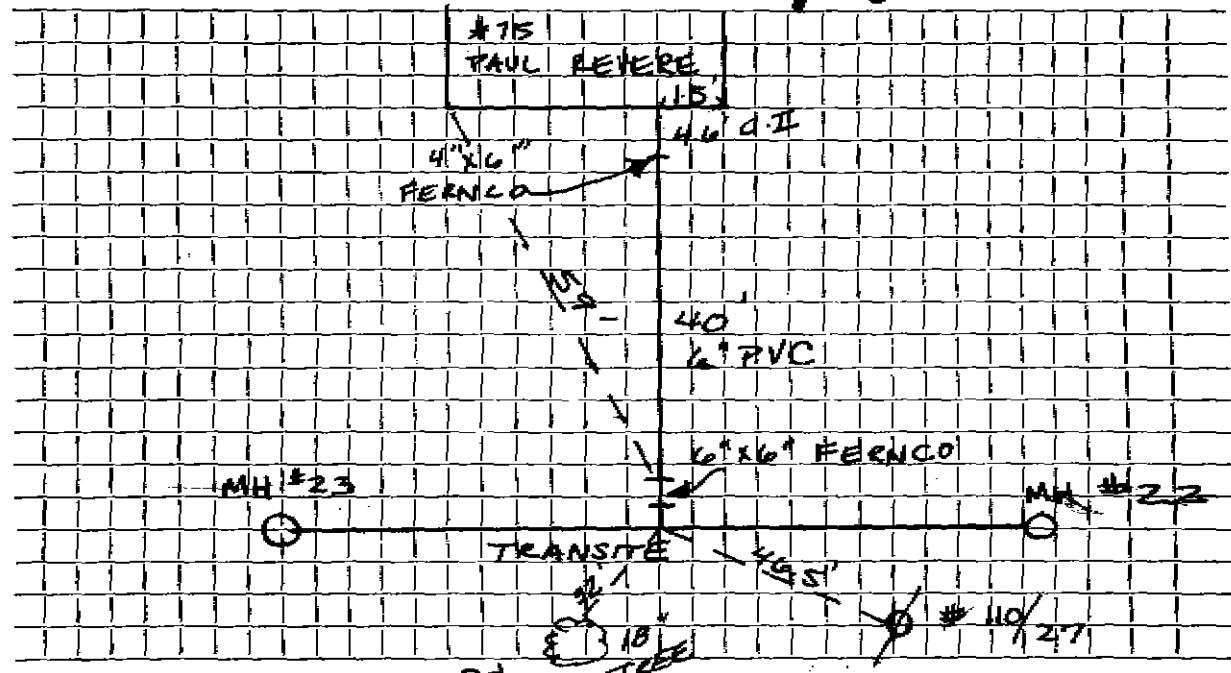

Connection made in PAUL REVERE Rd. Street. Work completed BY: VALERI  
Remarks: 3' Down Original Service 3-25-59 (59'-6" Transite, 1-6" 90° Elbow, 1-6x8" Wye)