

Name

Service No.

Address

9 Paul Roward

Location

Kind of Pipe

Size of Main

Repair—Renewal—New Service

Location


Date	Material	Amount	Total	Date	Amount
8-10-07	Service Renewed			7-9-84	39' 6" PVC cable AC to PVC Adpt
	4X6 PVC to PVC Framed				
	6X6 PVC to PVC Framed				
	1-6" 450 BAND				
	6X6X4 WYR CEMENT OUT				
	17'-6" PVC PIPE				

DATE _____

TOWN OF LEXINGTON — BOARD OF PUBLIC WORKS

SEWER DIVISION

Sketch of Service Here

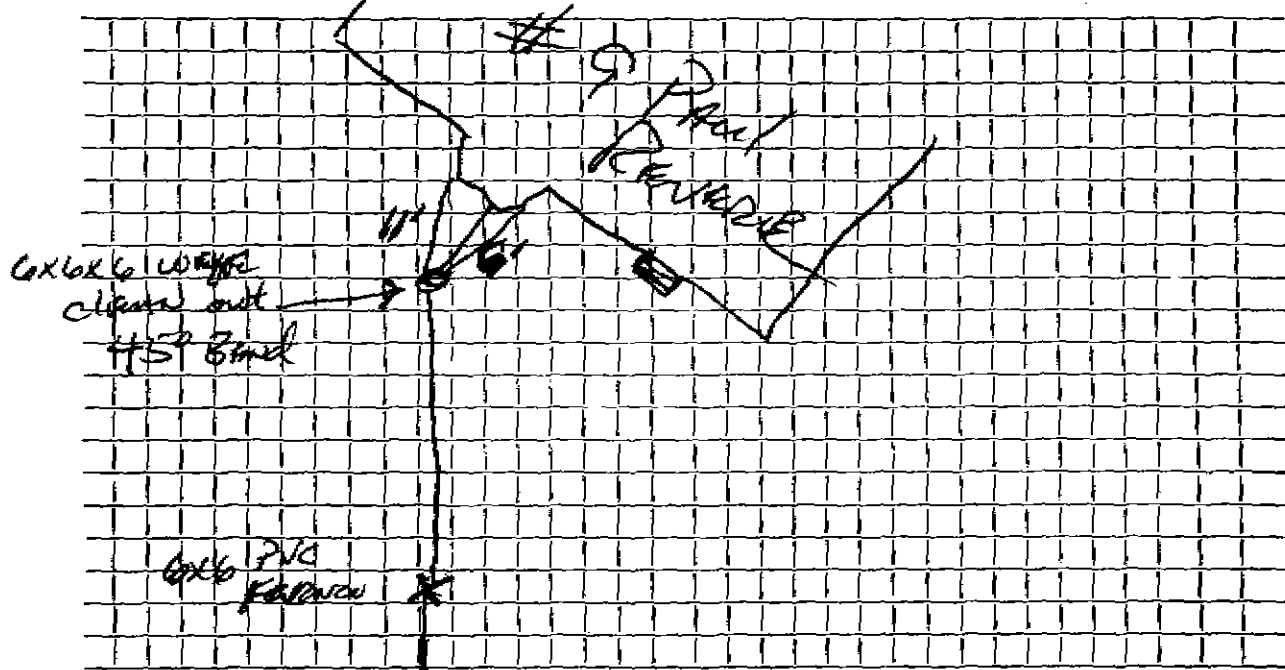

Connection made in Street. Work completed

Remarks: 8' 117' 5' x 4' 5' x 4'

SERVICE ON PAINT REVERSE RS