

Name Edward Savage

Service No. 162

Address 1 Payson Street

Payson Street

Location

Kind of Pipe

Permit #A 18

Size 6"

Size of Main 8"

~~XXXXXXXXXX~~ New Service T. D. Sullivan & Son

Location DEC 31 1965

Item	Material	Amount	Total	Date		Amount
5	29' 6" Transite pipe @	7.00	203.00	9-22-65	Deposit	203.00
	57' 6" Transite pipe					
				1965		
					29' 6" Transite	
					1 6" X 8" Wye	
29	Repair made under water main			9-8-69	Service appears to have been broken 88' out	
	6' - 6" PVC					
	2 - 6" AC to PVC Franco's					
	1 - 0" PVC to PVC Franco					

Name Edward Saraga

Service No. 162

Address 1 Payson Street

1 Payson Street

Location

Kind of Pipe Permit #A 18

Size 6"

Size of Main 8"

~~Repair Work~~ New Service T. D. Sullivan & Son

Location DEC 31 1965


Date	Material	Amount	Total	Date	Amount
65-29	6" Transite pipe @	7.00	203.00	9-22-65	203.00
1-65	6" Transite pipe				
				1965	
				29'	6" Transite
					1 6" X 8" Wye
9-99	Repair MADE under water main			9-89	France appears to have been broken 88' out
	6' - 6" PVC				
	2 - 6" AC to PVC FRANCE				
	1 - 6" PVC to PVC FRANCE				

130

DATE _____

TOWN OF LEXINGTON — BOARD OF PUBLIC WORKS
SEWER DIVISION

Sketch of Service Here

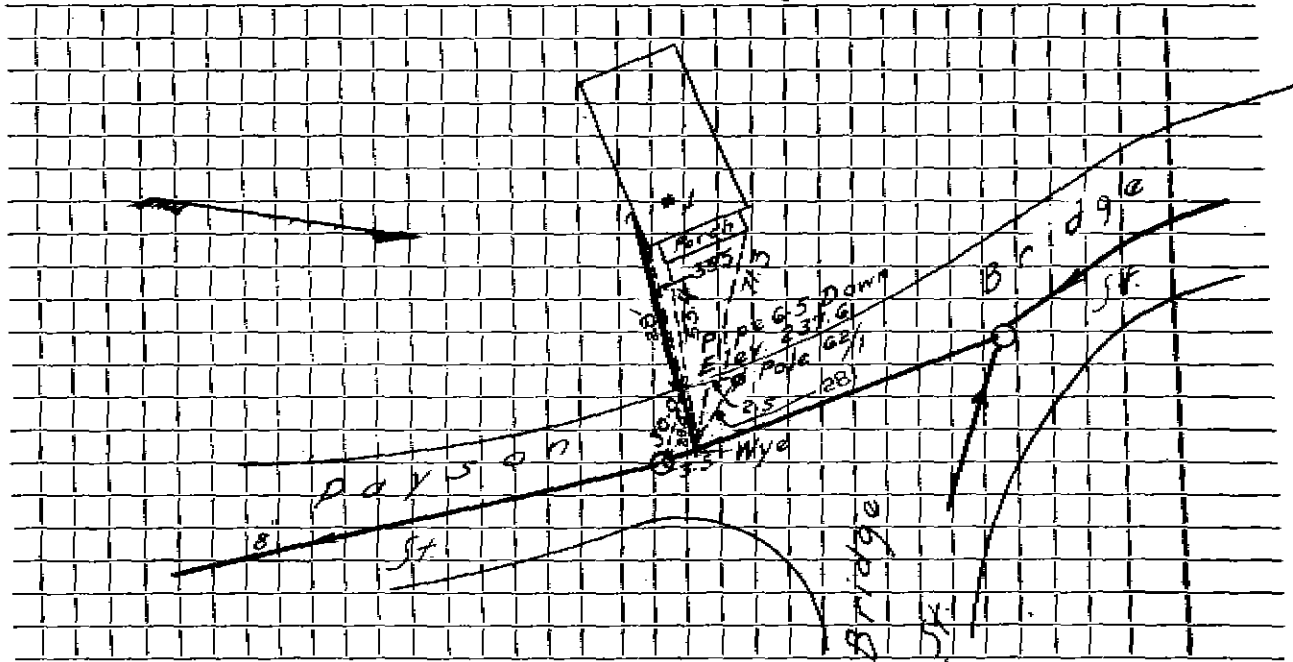

Connection made in _____ Street. Work completed _____


Remarks: service Broken during water main installation

DATE _____

TOWN OF LEXINGTON — BOARD OF PUBLIC WORKS

SEWER DIVISION

Sketch of Service Here /

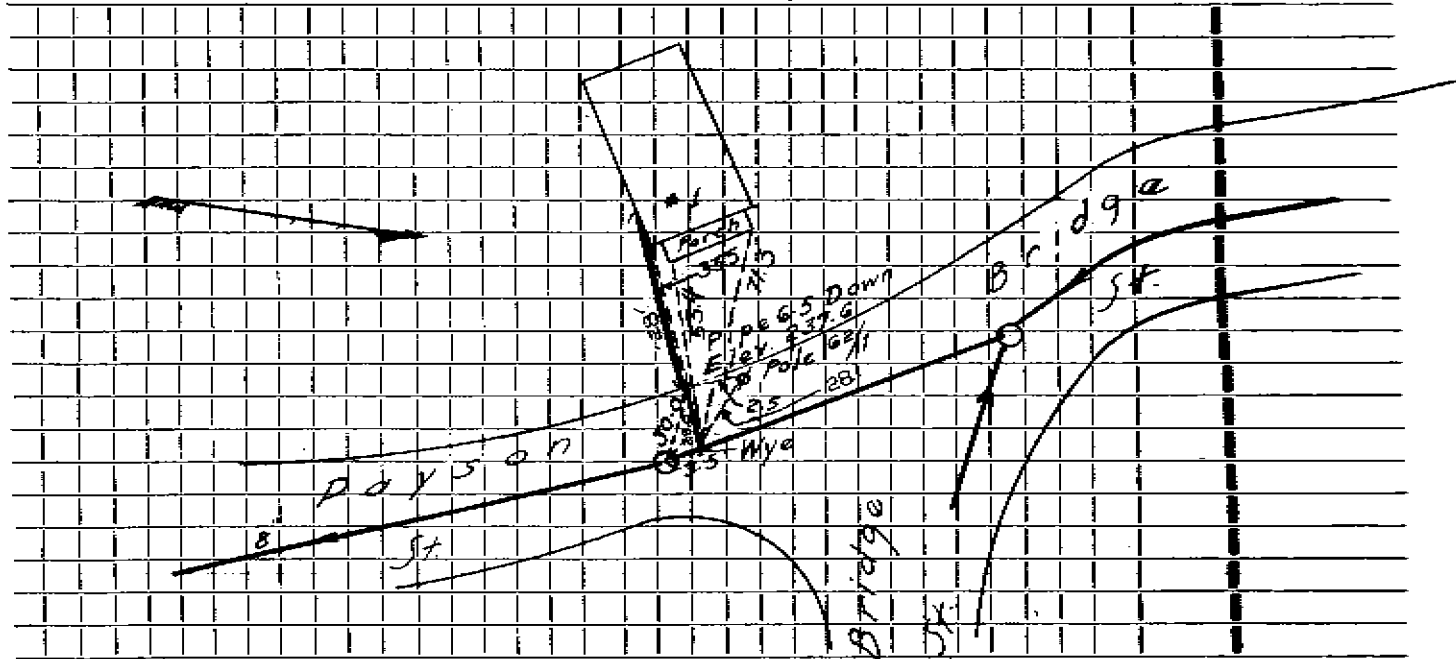

Connection made in Street. Work completed

Remarks: service Broken during water main installation.....