

Name

Service No.

Address 10 Payson Street

10 Payson Street

Location

Kind of Pipe

Size 6"

Size of Main 8"

Repair—Renewal—New Service

Location


Date	Material	Amount	Total	Date	Amount
163	6" cast-iron pipe @7.00		112.00		
1965				16' 6" TRANSITE	
1				6" X 8" WYE	

DATE _____

TOWN OF LEXINGTON — BOARD OF PUBLIC WORKS
SEWER DIVISION

Sketch of Service Here

10

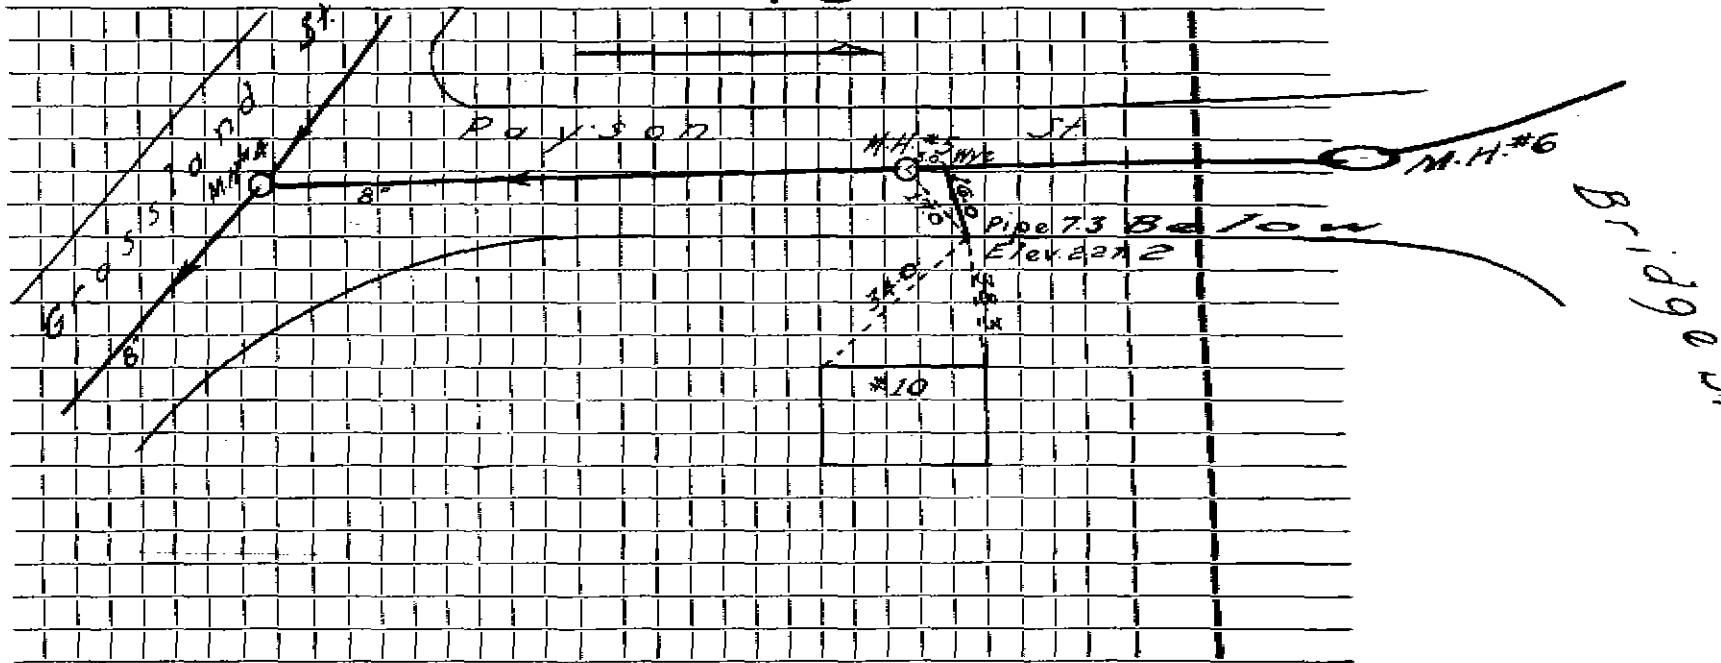

Connection made in Street. Work completed

Remarks:

.....

.....