


DATE 8/20/19

TOWN OF LEXINGTON — BOARD OF PUBLIC WORKS
SEWER DIVISION

Sketch of Service Here

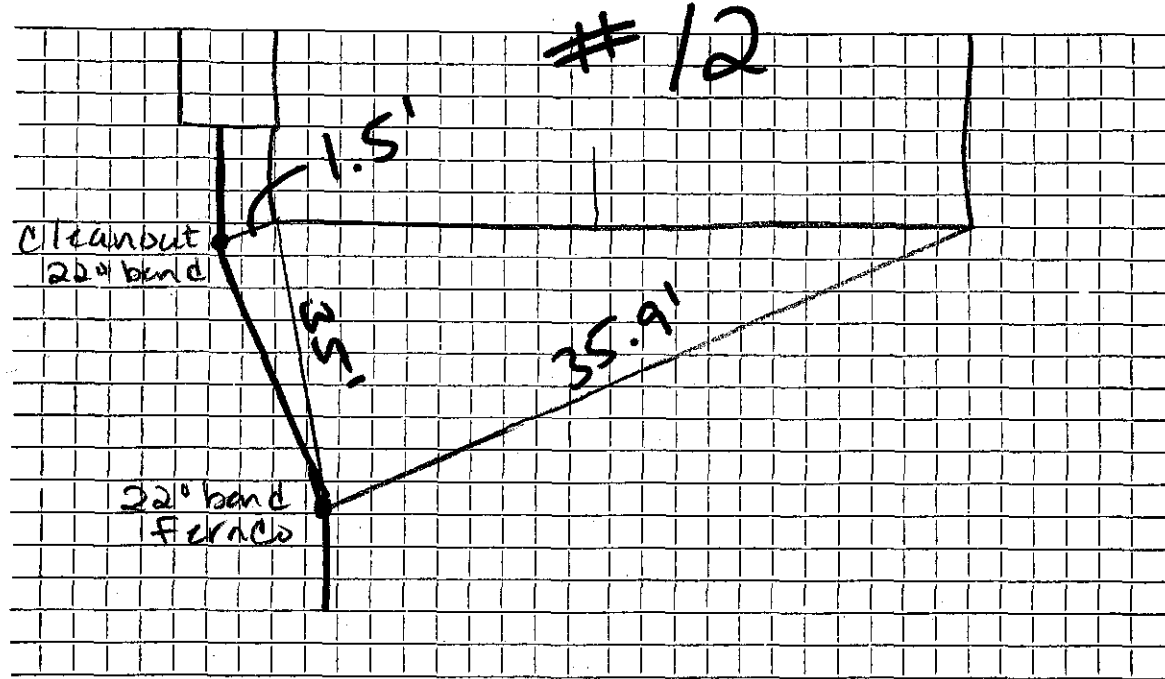

Connection made in Payson Street. Work completed

Remarks: depth @ cleanout = 6'