

3-117

Service No.

Address 3 Payson Street

Lot #197 3 Payson Street Location

Kind of Pipe Size 6"

Size of Main 8"

Repair ~~Renewal~~ New Service W.O. #5763

Location


Quantity	Material	Amount	Total	Date	Amount
	<b>MAIN TO CURB</b>				
7	Labor	117 52			
	10% O.H.	11 75	129 27		
30'	6" Transite pipe @ .88		26 40		
2	Hrs. Trucking @ 3.00		6 00		
4	Hrs. Shovel @ 6.50		26 00		
2	Hrs. Loader @ 4.00		8 00		
			195 67		

DATE \_\_\_\_\_

TOWN OF LEXINGTON — BOARD OF PUBLIC WORKS

SEWER DIVISION

Sketch of Service Here **3**

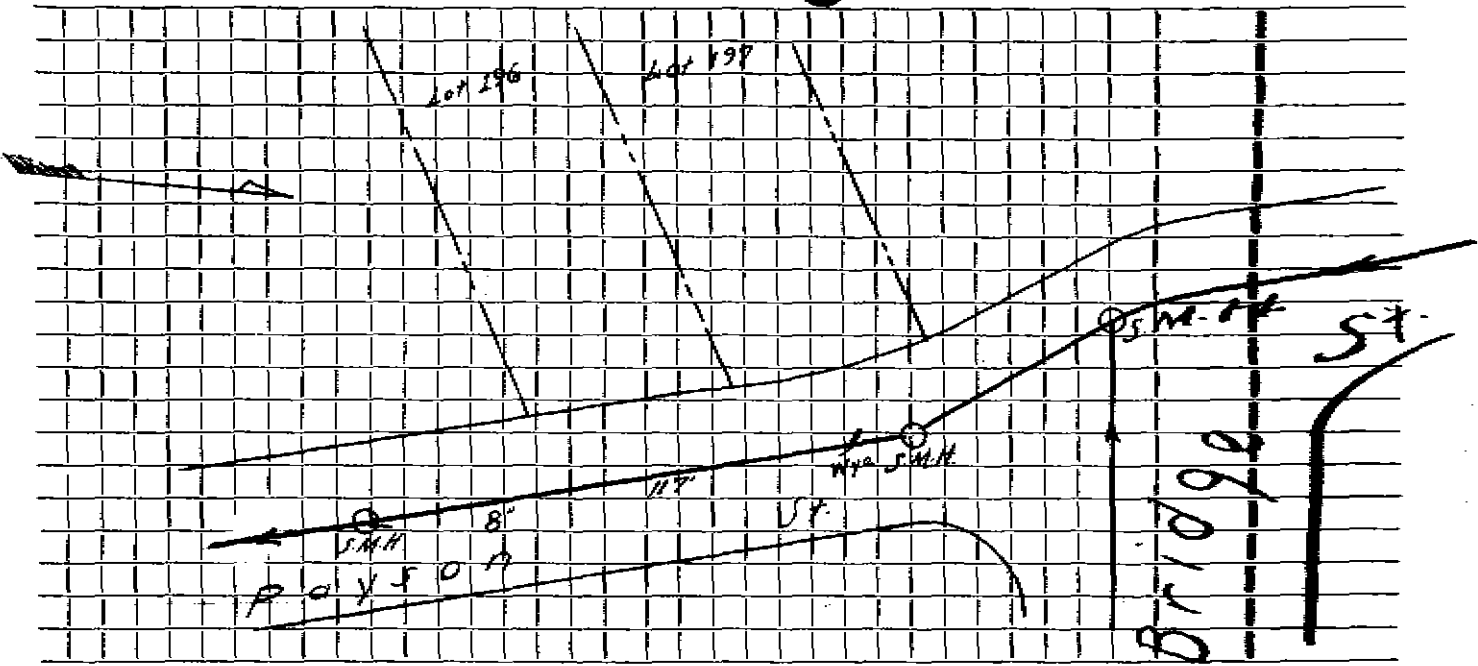

Connection made in ..... Street. Work completed .....

Remarks: .....  
.....  
.....