

Name **Amelio Bertelli**

Service No. 68

Address **4 Payson Street**

4 Payson Street

Location

Kind of Pipe

Size **6"**

Size of Main **8"**

~~SEWER SERVICE~~ **New Service Craftsman Inc. Permit #A302**

Location **JUN 23 1966**


Date	Material	Amount	Total	Date	Amount	
1965	19' 6" Transit pipe @7.00		133.00	6-23-66	Deposit	133.00
15'	6" Transit pipe					
10'	Cast iron pipe			1965	19' 6" Transite	
	1-7	133			1 6" X 8" Wye	

DATE _____

TOWN OF LEXINGTON — BOARD OF PUBLIC WORKS
SEWER DIVISION

Sketch of Service Here

4

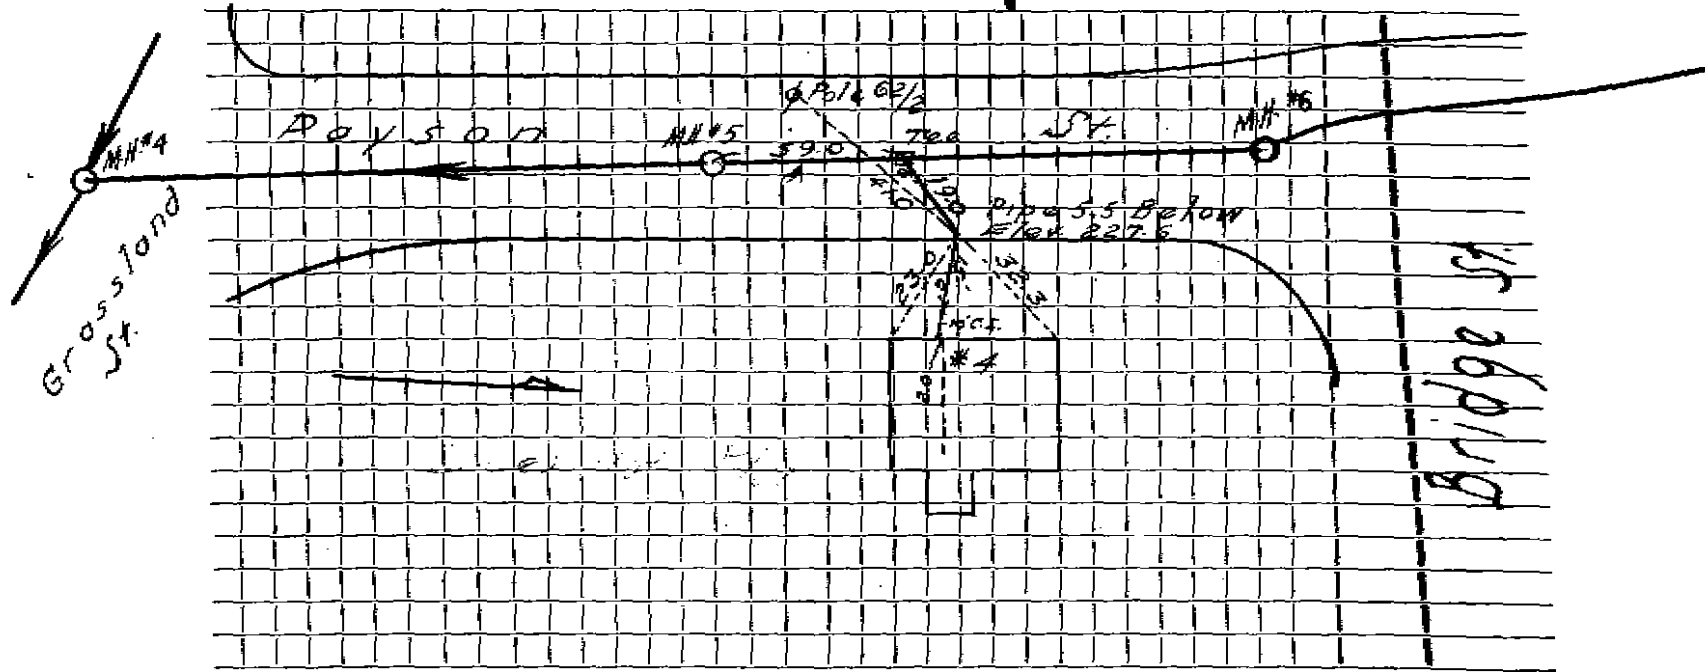

Connection made in Street. Work completed

Remarks:

.....

.....