

5-196

Name _____ Service No. _____

Address **5 Payson Street**

Lot #196 5 Payson Street Location _____

Kind of Pipe _____ Size **6"** Size of Main **8"**

Repair—~~Renewal~~—New Service W O #5785 Location _____

Date	Material	Amount	Total	Date	Amount
	MAIN TO CURB				
/67	Labor	117 52			
	10% O.H.	11 75	129 27		
28'	6" Transite pipe @ .88		24 64		
1	Bend		4 09		
1	ELBOW		4 09		
2	Hrs. Trucking @ 3.00		6 00		
4	Hrs. Shovel @ 6.50		26 00		
2	Hrs. Loader @ 4.00		8 00		
			<u>202 09</u>		


DATE _____

TOWN OF LEXINGTON — BOARD OF PUBLIC WORKS

SEWER DIVISION

Sketch of Service Here

5

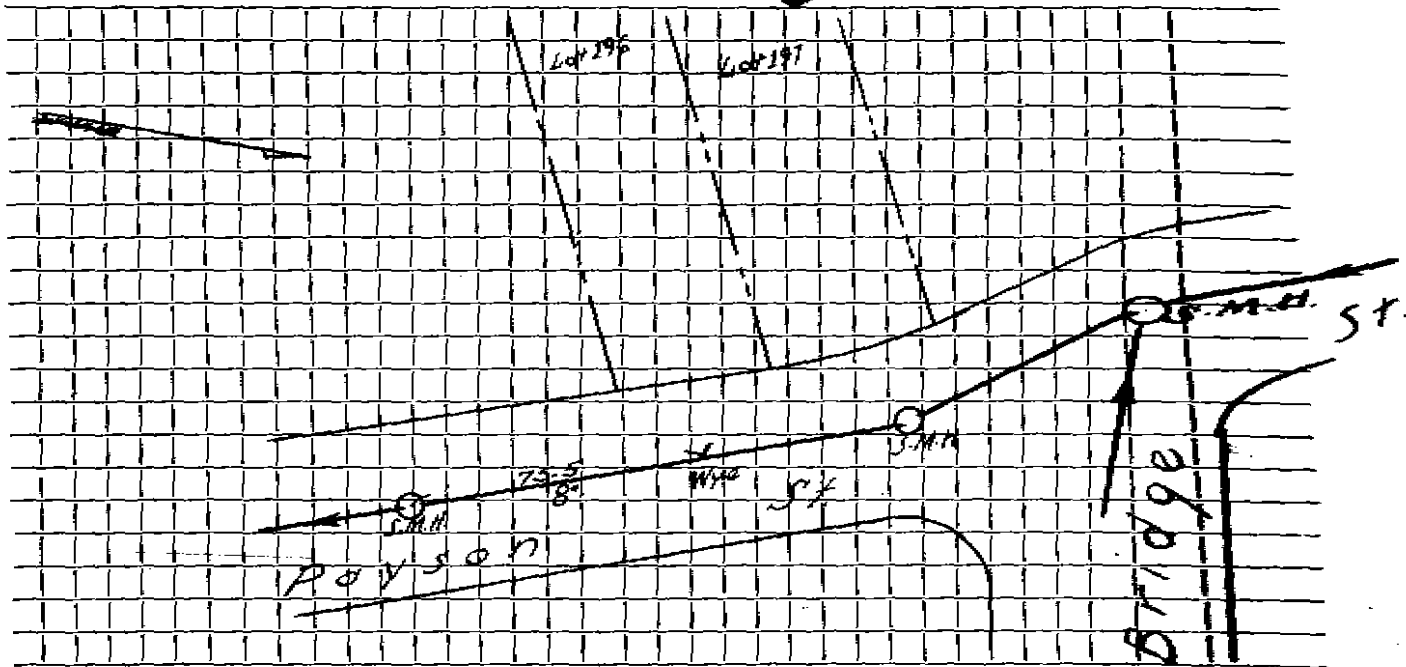

Connection made in Street. Work completed

Remarks:
.....
.....