

Name

Service No.

Address

8 Payson St

Location

Kind of Pipe

SDR 35 PVC

Size

6"

Size of Main

Repair

Renewal

New Service

Location

Date

Material

Amount

Total

Date

Amount

11/24/20

6" cleanout
SDR 35 PVC
with tee wye


6" SDR 35 PVC
PIPE

6" Fern Co

DATE 11/24/2020

TOWN OF LEXINGTON — BOARD OF PUBLIC WORKS
SEWER DIVISION

Sketch of Service Here

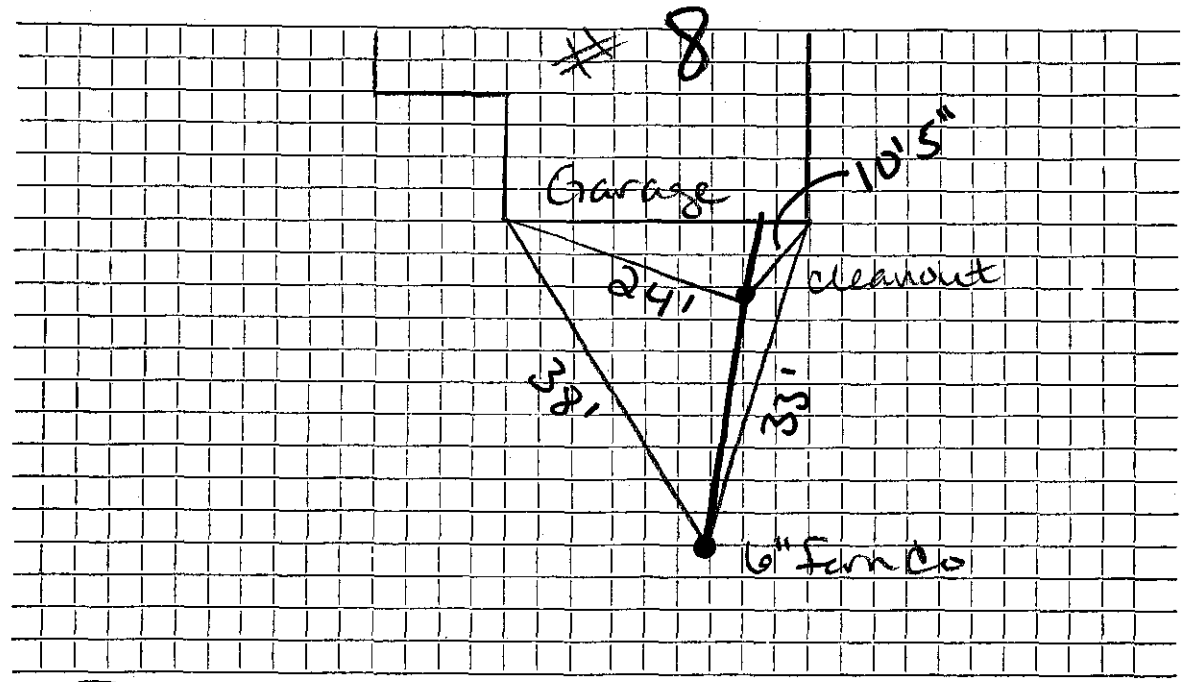

Connection made in Payson St Street. Work completed

Remarks:
.....
.....