

三

Address 10 Peachtree

Services

三


### Kind of Pipe

Remarks:

Connection made in

Street.

Work completed

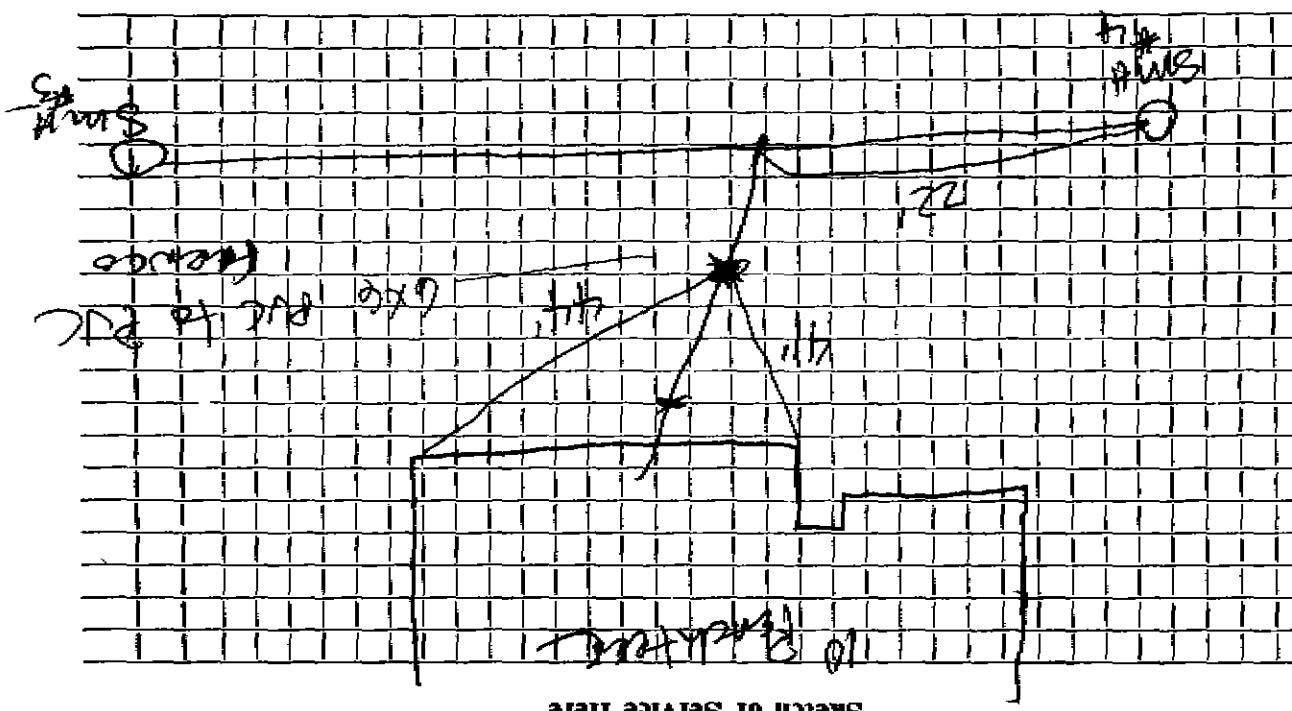

Sketch of Service Here

## SEWER DIVISION

TOWN OF LEXINGTON — BOARD OF PUBLIC WORKS

DATE