


TOWN OF LEXINGTON — BOARD OF PUBLIC WORKS
SEWER DIVISION

Sketch of Service Here

14

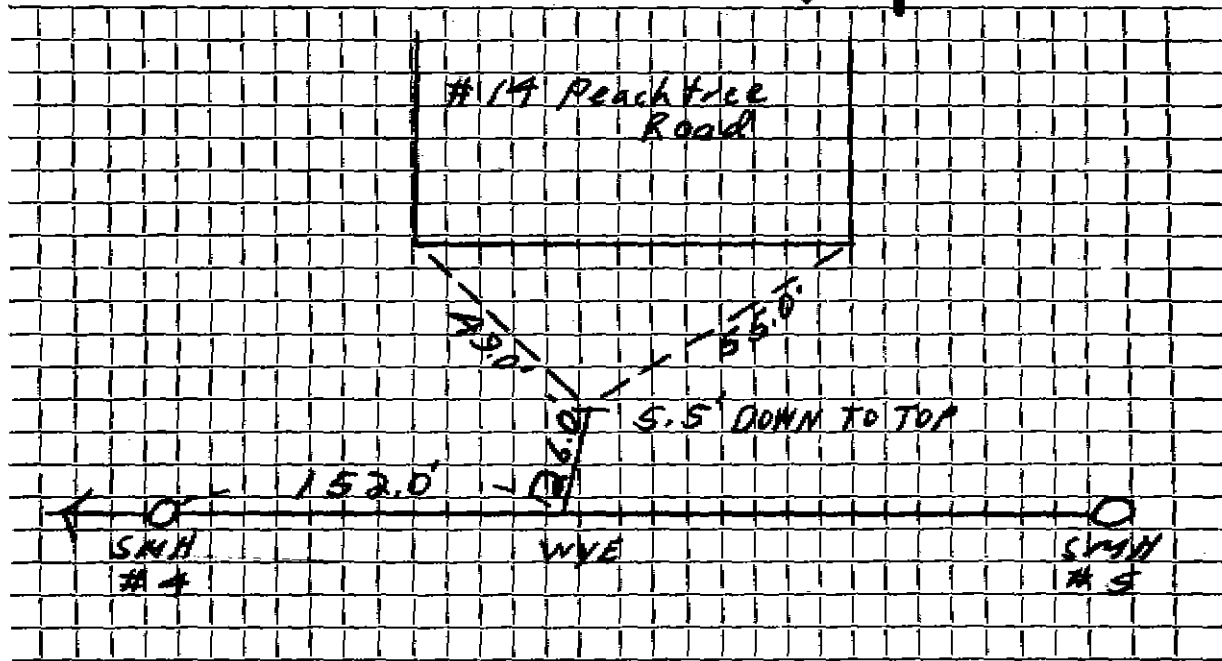

Connection made in Peachtree Street. Work completed

Remarks:

.....

.....