


DATE JUNE 1975

TOWN OF LEXINGTON — BOARD OF PUBLIC WORKS

SEWER DIVISION

Sketch of Service Here

15

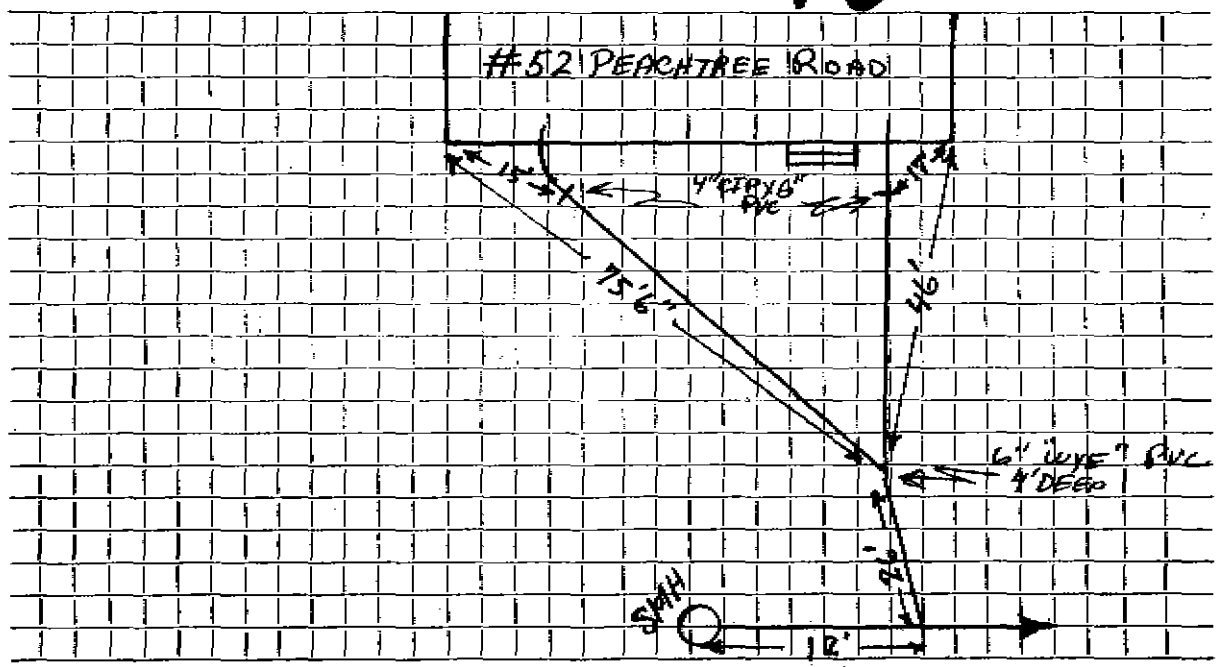

Connection made in PEACHTREE RD Street. Work completed NOV 30, 1983

Remarks:

.....

.....