

Name **Jack L. Mitchell**

Service No. **40**

Address **16 Peachtree Road**

16 Peach Tree Road

Location

Kind of Pipe

Size **6"**

Size of Main **8"**

~~XXXXXXXXXX~~ **New Service** WO # **8431**

Location **JUN 9 1964**

Date	Material	Amount	Total	Date	Amount
-/63	15.5' 6" A.C. installed by contractor @6.00 per foot			4-3-64 8-28-64 10- - 63	400.00 47.98 352.10
	BILL WHEN CONNECTED	93.00		15.5' 6" Transite 4-28-69 17' 6" Transite	
3-64	Labor	99.38			
8-64	"	12.00	111.38		
	10% O.H.		11.14		
	84' 6" Transite pipe @.82		68.88		
	1 Bag Cement		1.50		
	14 yds. Loam @2.00		28.00		
	XX Fertilizer & Lime		2.00		
	1 11 1/2" Transite Elbow		2.35		
	1 22 1/2" Transite Elbow		2.35		
	3 hrs. Tom Shovel @6.50		19.50		
	3 hrs. Trucking @3.00		9.00		
	1 hr. Trailer @3.00		3.00		
			<u>352.10</u>		
				1-3-66	GARBAGE DEBRIS
				11-14-60	DETERGENTS
				3/11/69	Lair Sell
				6/12/11	

Name **Jack L. Mitchell**

Service No. **40**

Address **16 Peachtree Road**

16 Peach Tree Road

Location

Kind of Pipe

Size **6"**

Size of Main **8"**

~~REPAIR~~ **New Service** *WO # 8631*

Location **JUN 9 1964**

Date	Material	Amount	Total	Date	Amount
-/63	15.5' 6" A.C.			4-3-64	Deposit 400.00
	installed by			8-29-64	Retrad 47.90
	contractor @6.00			10- - 63	352.10
	per foot	93.00			15.5' 6" Transite
	BILL WHEN CONNECTED			4-28-69	17' 6" Transite
3-64	Labor	99.38			
8-64	"	12.00	111.38		
	10% O.H.		11.14		
	84' 6" Transite pipe @.82		68.88		
	1 Bag Cement		1.50		
	14 yds. Loam @2.00		28.00		
	XX Fertilizer & Lime		2.00		
	1 11 1/2" Transite Elbow		2.35		
	1 22 1/2" Transite Elbow		2.35		
	3 hrs. Town Shovel @6.50		19.50		
	3 hrs. Trucking @3.00		9.00		
	1 hr. Trailer @3.00		3.00		
			<u>352.10</u>		
				1-3-66	GARBAGE DEBRIS
				11-14-66	DETERGENTS
				3/17/69	Laid Sewer
				4/3/69	Debris


DATE

TOWN OF LEXINGTON — BOARD OF PUBLIC WORKS

SEWER DIVISION

Sketch of Service Here

16

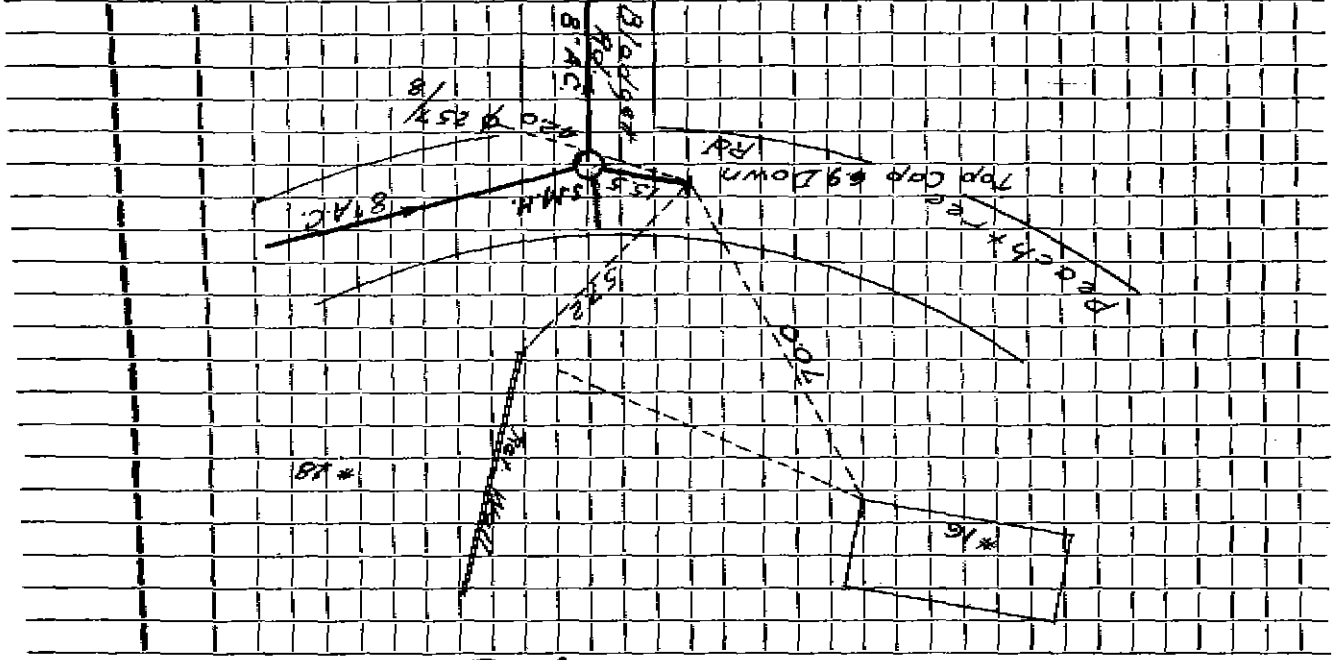


Street. Work completed

Connection made in

Remarks:

SEWER DIVISION

Sketch of Service Here **16**

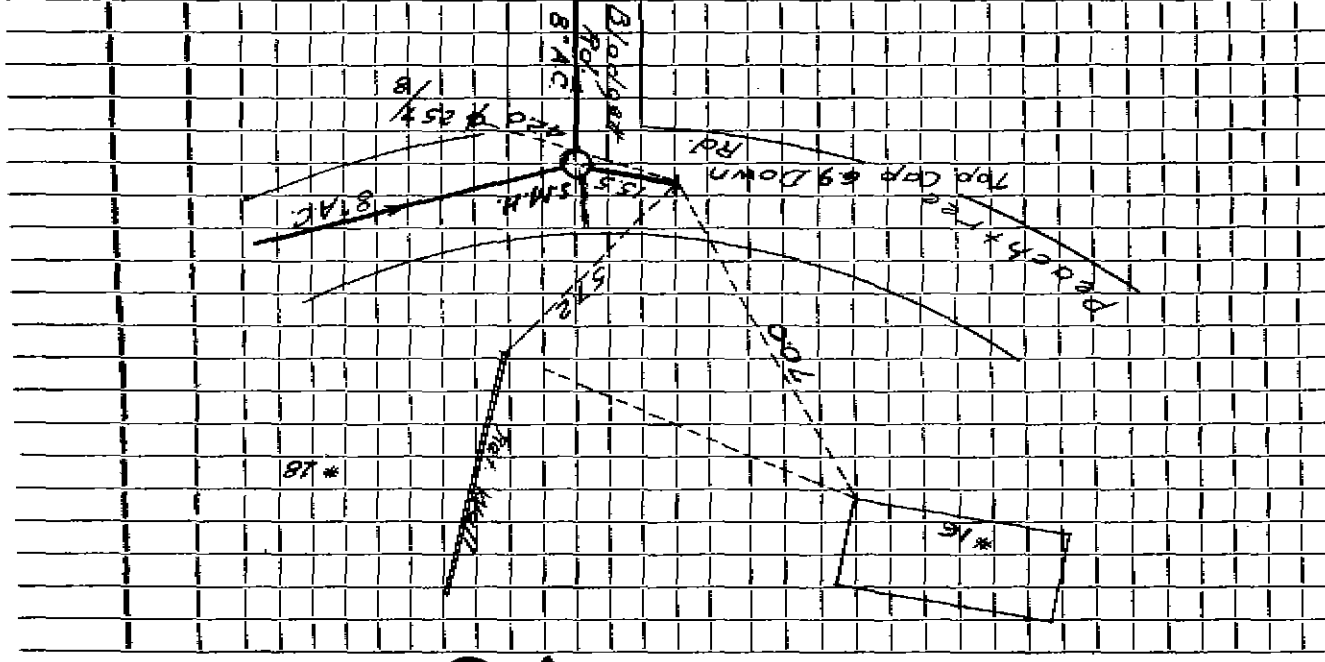

Work completed

Street.

Connection made in

Remarks: