

Name Thomas A. Kirkham Service No. 74

Address 17 Peachtree Road

7 Peachtree Road Location

Kind of Pipe _____ Size 6" Size of Main 8"

~~XXXXXXXXXXXX~~ New Service WO # 8711 Location JUN 29 1964


Date	Material	Amount	Total	Date	Amount
1/63	32' 6" 6" A.C. installed by contractor @6.00 per foot	192.00		5-4-64 11-13-64 10- - 63	425.00 21.05 517.05
	BILL WHEN CONNECTED			32' 6" Transite 1 6" x 8" Wye	
-64	Labor	45.00			
-64	"	97.50	142.50		
	10% O.H.		14.25		
85'	6" Transite pipe @.82		69.70		
1	bag Cement		1.50		
2	1 1/2" Transite Elbows @2.35		4.70		
1	22 1/2" Transite Elbow		2.35		
2	22 1/2" Transite Bend @4.09		8.18		
1	Adapter		1.62		
12	yds. Loam @3.00		36.00		
4 1/2	hrs. Town Shovel @6.50		29.25		
4	hrs. Trucking @3.00		12.00		
1	hr. Trailer @3.00		3.00		
			517.05		
					Bill amt 9205

DATE _____

TOWN OF LEXINGTON — BOARD OF PUBLIC WORKS
SEWER DIVISION

Sketch of Service Here

17

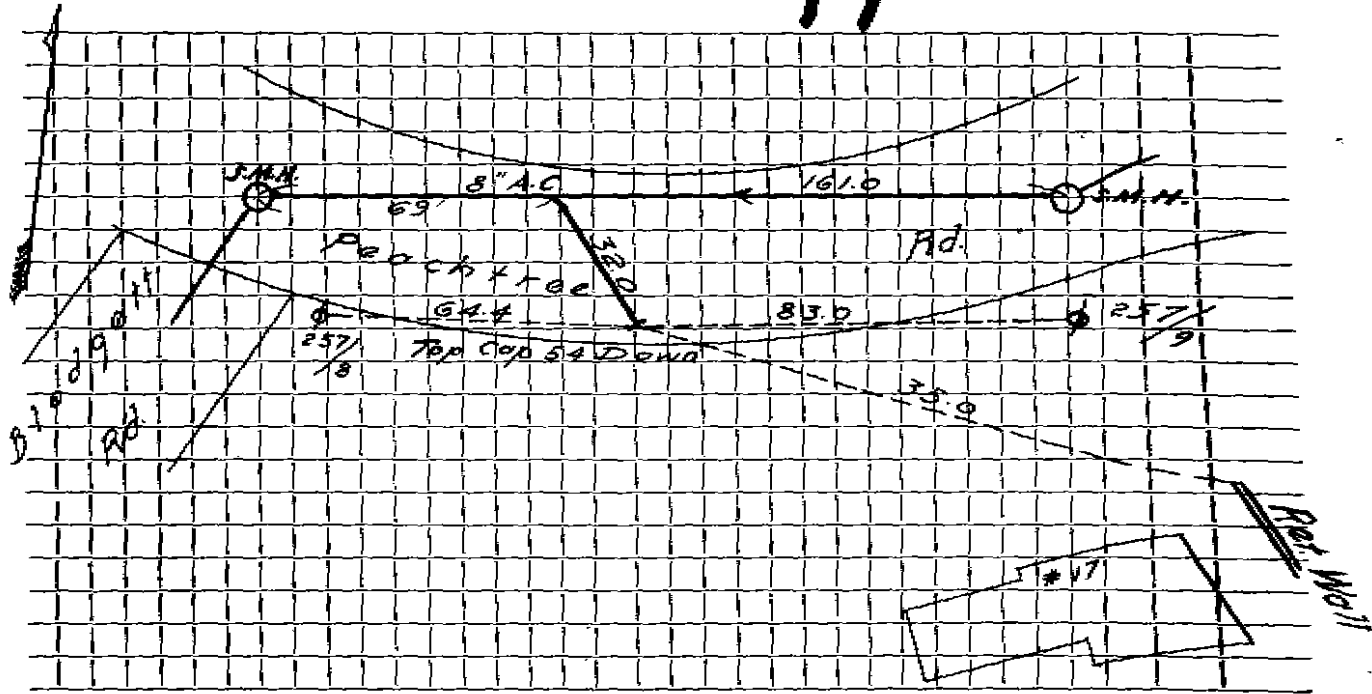

Connection made in Street. Work completed

Remarks:

.....

.....