

Name **Leopold F. Bornstein**

Service No. **22**

Address **18 Peachtree Road**

18 Peach Tree Road

Location

Kind of Pipe

Size **6"**

Size of Main **8"**

~~Water~~ **New Service**

W off #589


Location **Comm 5-18-64**

Date	Material	Amount	Total	Date	Amount
-/63	24' 6" A.C. installed by contractor @6.00 per foot	144 00		3-16-64 6-21-64 10- -63	325 00 29 60 354 60
	BILL WHEN CONNECTED			24' 6" Transite 1 6" X 8" Wye	
3-64 28-64	Labor 81.04 " 31.20 10% O.H.	112.24 11.22	123.46		
	40' 6" Transite pipe @.82		32.80		
	1 11 1/2° Transite Bend		4.09		
	1/2 ton 1 1/2" Stone @1.50		6.75		
	5 yds. Loam @3.00		15.00		
	3 hrs. Trucking @3.00		9.00		
	3 hrs. Town Shovel @6.50		19.50		
			354.60		
					Bill sent 29.60

DATE _____

TOWN OF LEXINGTON — BOARD OF PUBLIC WORKS
SEWER DIVISION

Sketch of Service Here **18**

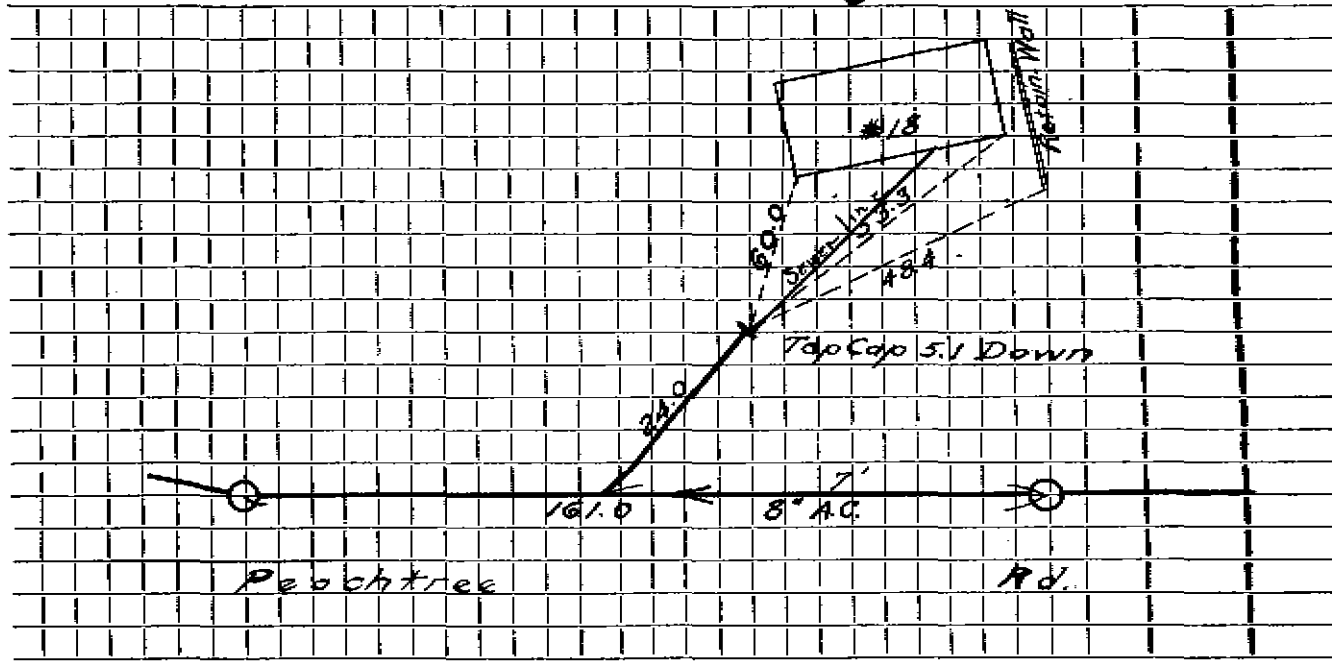

Connection made in Street. Work completed

Remarks:
.....
.....