

Name William H. Barnett

Service No. 27

Address 19 Peachtree Road

19 Peachtree Road

Location

Kind of Pipe

Size 6"

Size of Main 8"

~~Existing~~ New Service W of # 8596

Location JUN 29 1964

Date	Material	Amount	Total	Date	Amount
-/63	<del>16.5' 6" A.C.</del> installed by contractor @6.00 per foot	99 00		3-23-63 10-15-64 10- -63	366 60 59 21 359 21
	BILL WHEN CONNECTED			16.5' 6" Transite 1 6" X 8" Wye	
8-64	Labor	81.04			
3-64	"	43.64	124.68		
	10% O.H.		12.47		
	59' 6" Transite pipe @.82		48.38		
	1 11 1/2° Transite Bend		4.09		
	1 22 1/2° Transite Bend		4.09		
	11 yds. Loan @2.00		22.00		
	5 hrs. Town Shovel @6.50		32.50		
	4 hrs. Trucking @3.00		12.00		
			359.21		
					Billed 59 21


DATE \_\_\_\_\_

TOWN OF LEXINGTON — BOARD OF PUBLIC WORKS

SEWER DIVISION

Sketch of Service Here

18

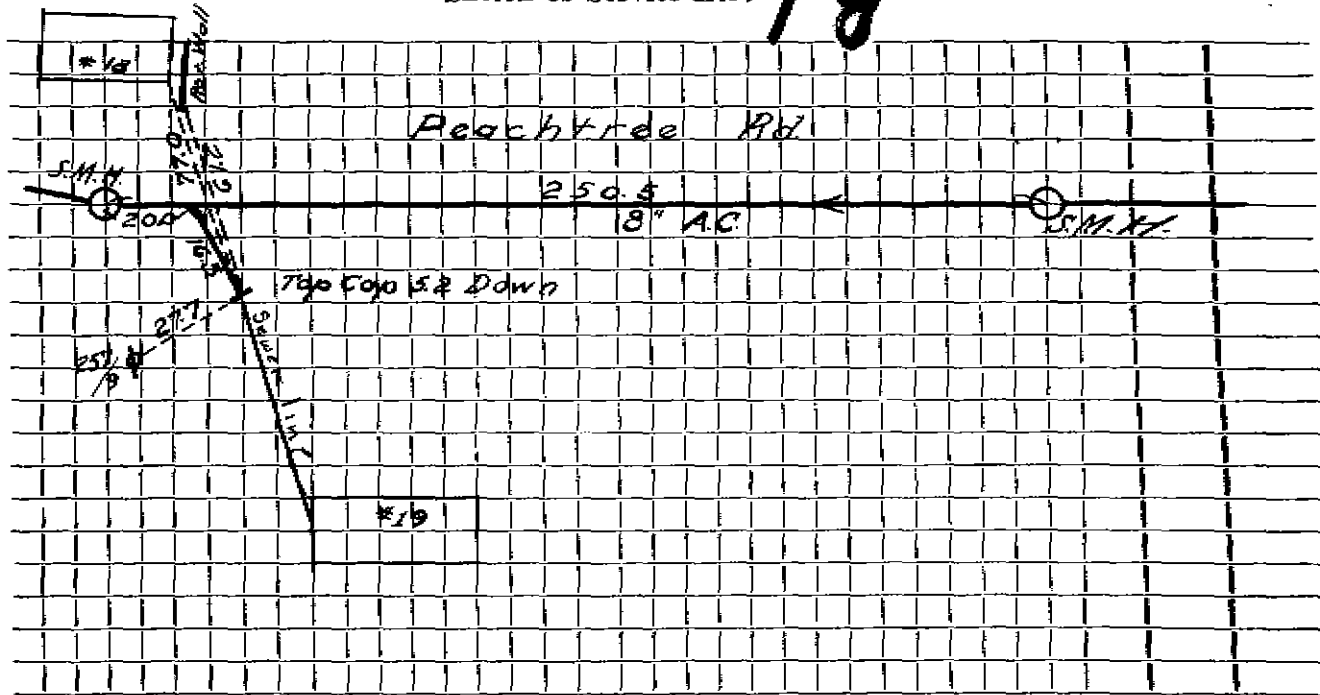

Connection made in ..... Street. Work completed .....

Remarks: .....  
.....  
.....