

Name **Harris Cohen**

Service No. **166**

Address **20 Peachtree Road**

**20 Peachtree Road**

Location

Kind of Pipe

Size **6"**

Size of Main **8"**

~~Repair~~ **New Service** Kirkland & Shaw Permit #1

Location **OCT 25 1965**


Date	Material	Amount	Total	Date	Amount
<del>5-24-65</del>	<del>20' 6" Transite pipe @6</del>	<del>00</del>	<del>120.00</del>	<del>9-22-65</del>	<del>150.00</del>
24-65	40' 6" Transite pipe				30.00
				19 65	120.00
				20' 6" Transite	
				1 6" X 8" Wye	

DATE \_\_\_\_\_

TOWN OF LEXINGTON — BOARD OF PUBLIC WORKS

SEWER DIVISION

Sketch of Service Here **20**

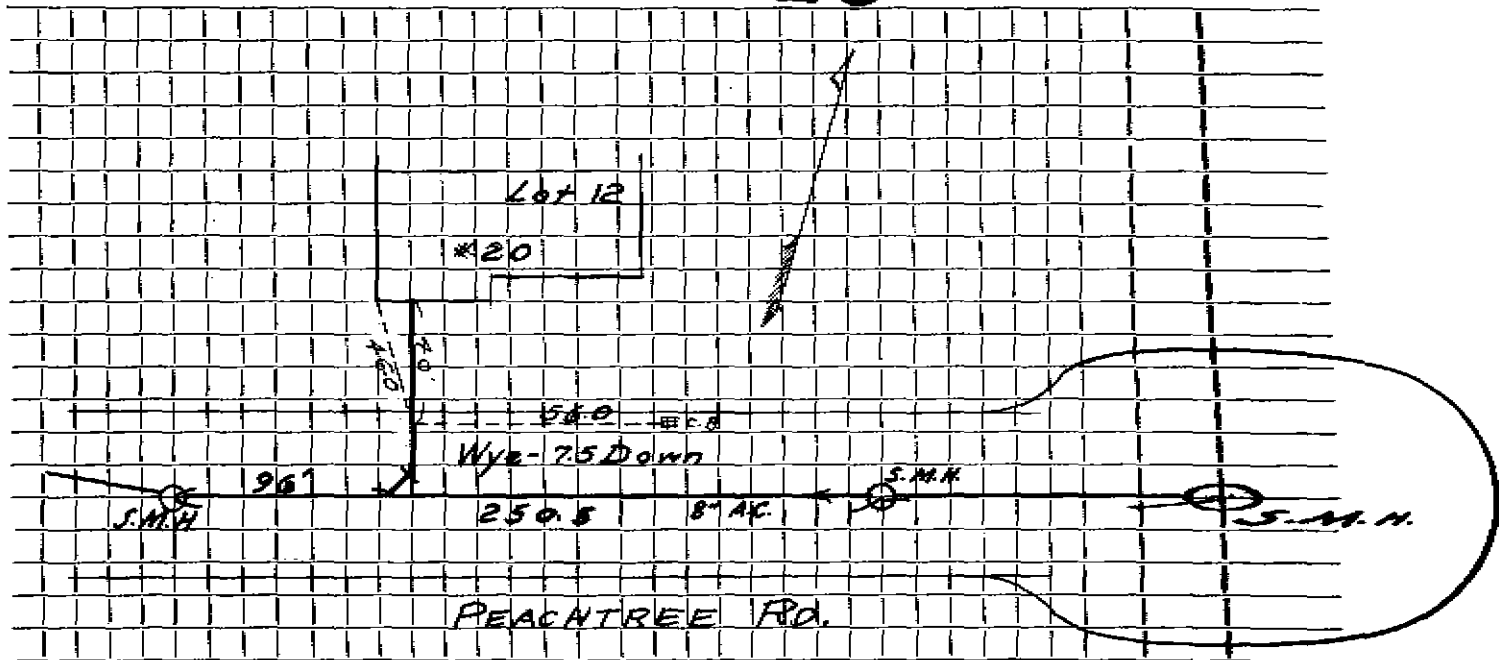

Connection made in ..... Street. Work completed .....

Remarks: .....

.....  
.....