

Name **Stephen Stavro**Service No. **145**Address **21 Peachtree Road****21 Peach Tree Road**

Location

Kind of Pipe

Size **6"**Size of Main **8"**~~Service Record~~ **New Service W.O. #9164**Location **DEC 28 1964**


Date	Material	Amount	Total	Date	Amount
-/63	10' 6" A.G. installed by contractor @6.00			8-31-64	350.00
	per foot	60 00		10-28-64	85.00
	BILL WHEN CONNECTED			10- -63	264.99
23-64	Labor	114 66		10' 6" Transite	
	10% O.H.	11 47	126 13	1 6" x 8" Wye	
56'	6" Transite pipe		45 92		
1	1 1/2 Bend		4 09		
1	1 1/2 Elbow		2 35		
1	Bag Cement		1 50		
2	Yds. Loam @3.00		6 00		
2	Hrs. Town Shovel @6.50		13 00		
2	Hrs. Trucking @3.00		6 00		
			264 99		

DATE _____

TOWN OF LEXINGTON — BOARD OF PUBLIC WORKS

SEWER DIVISION

Sketch of Service Here **21**

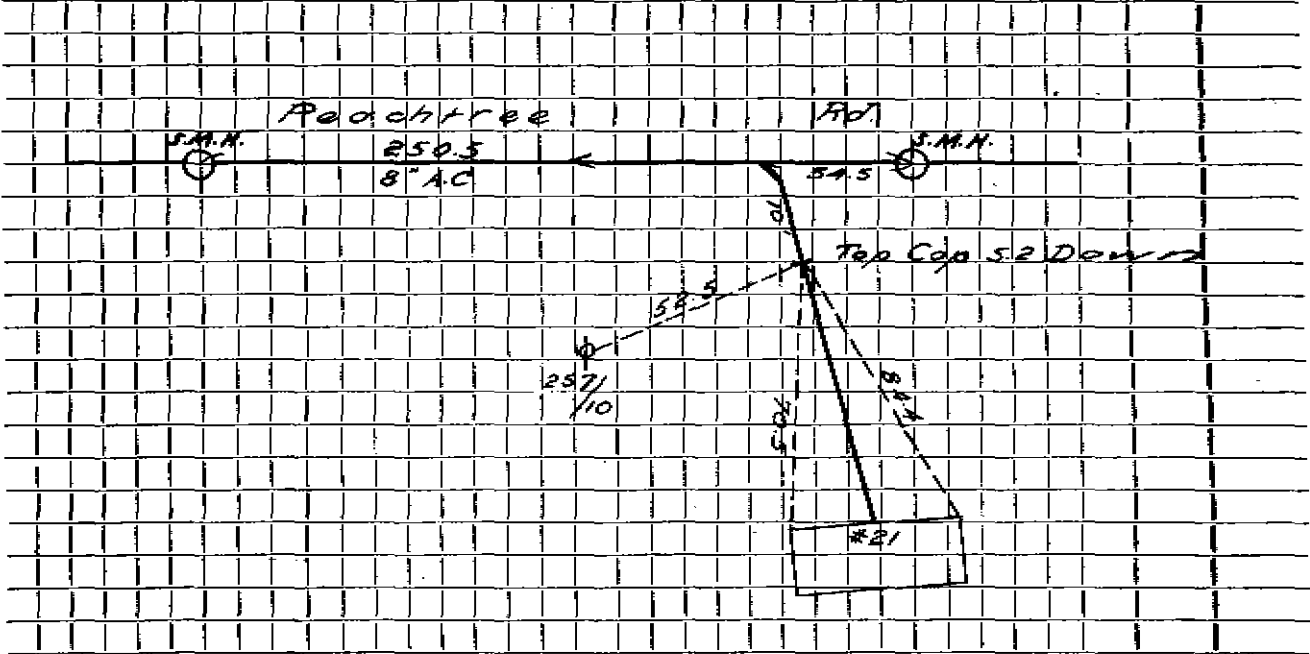

Connection made in Street. Work completed

Remarks:
.....
.....