

Name

Service No.

Address 22 Peachtree Road

22 Peach Tree Road

Location

Kind of Pipe

Size 6"

Size of Main 8"

Repair—Renewal—New Service

Location


Date	Material	Amount	Total	Date		Amount
/63	56.5' 6" A.C.					
	installed by					
	contractor @6.00			10 - 63		
	per foot	339 00			56.5' 6" Transit	
	BILL WHEN CONNECTED				1 6" X 8" Wye	

DATE _____

TOWN OF LEXINGTON — BOARD OF PUBLIC WORKS

SEWER DIVISION

Sketch of Service Here **22**

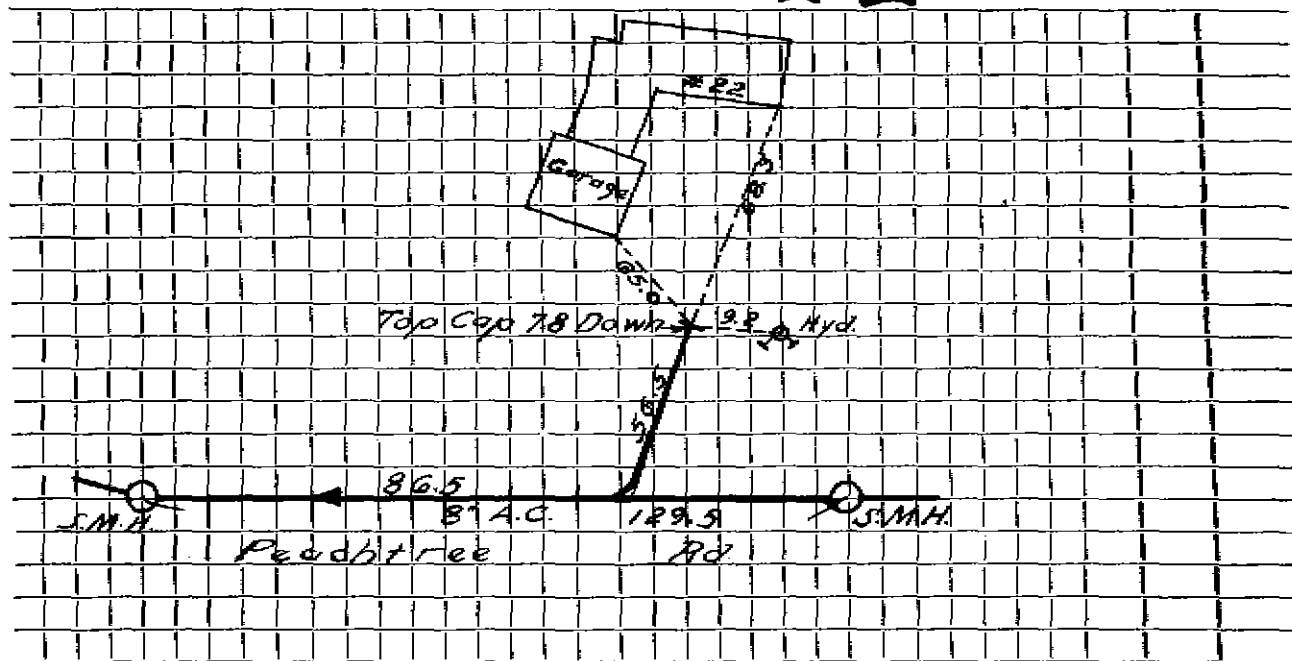

Connection made in Street. Work completed

Remarks:
.....
.....