

Name John Maehan

Service No. 174

Address 24 Peachtree Road

24 Peach Tree Road

Location

Kind of Pipe

Size 6"

Size of Main 8"

~~Basic Remarks~~ New Service Valeri Const. Co. - Permit #142


Location DEC 28 1964

Date	Material	Amount	Total	Date	Amount
1/63	<del>44' 6" A.C.</del> installed by contractor @6.00 per foot BILL WHEN CONNECTED	264 00		<u>10-26-64</u> <u>10-63</u>	<u>Deposit</u> <u>264.00</u>
3-64	179' 6" Transite pipe				<u>44' 6" Transite</u> <u>1 6" X 8" Wye</u>

DATE \_\_\_\_\_

TOWN OF LEXINGTON — BOARD OF PUBLIC WORKS  
SEWER DIVISION

Sketch of Service Here **24**

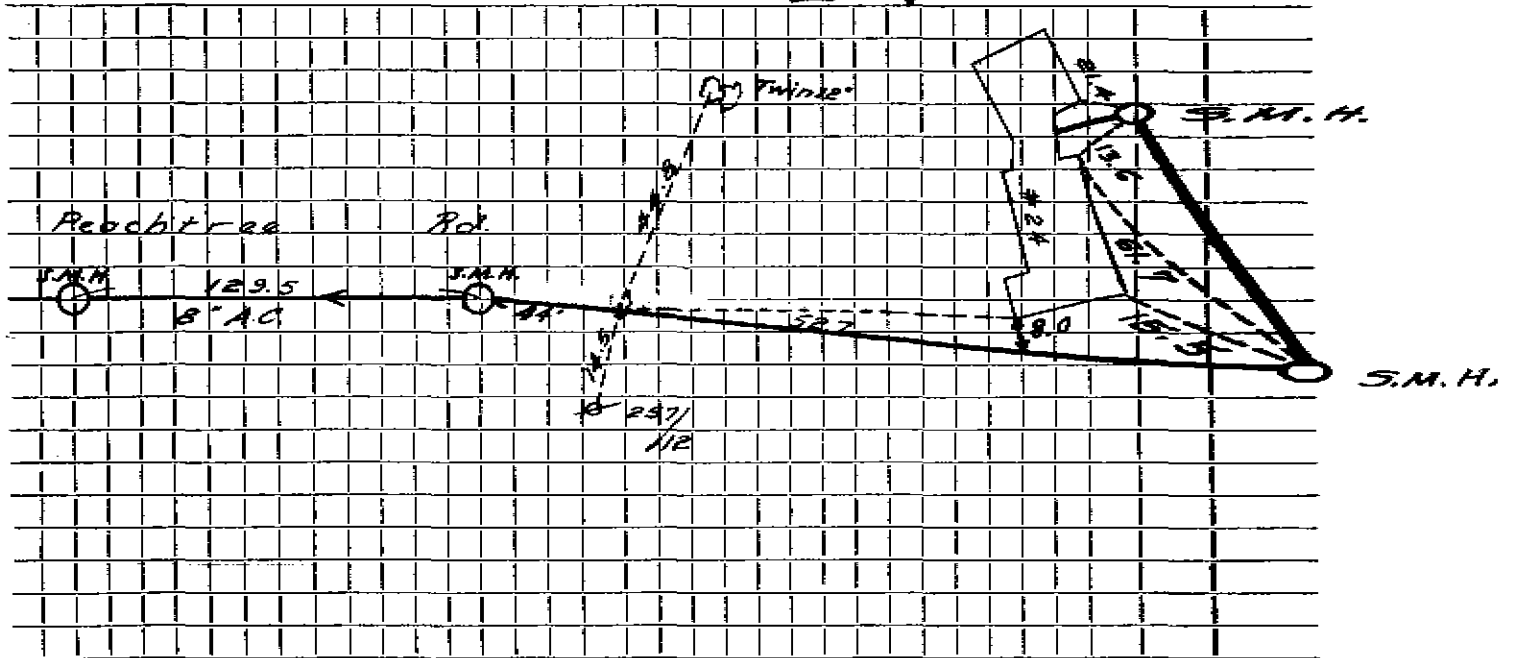

Connection made in ..... Street. Work completed .....

Remarks: .....  
.....  
.....