


TOWN OF LEXINGTON — BOARD OF PUBLIC WORKS

SEWER DIVISION

Sketch of Service Here

6

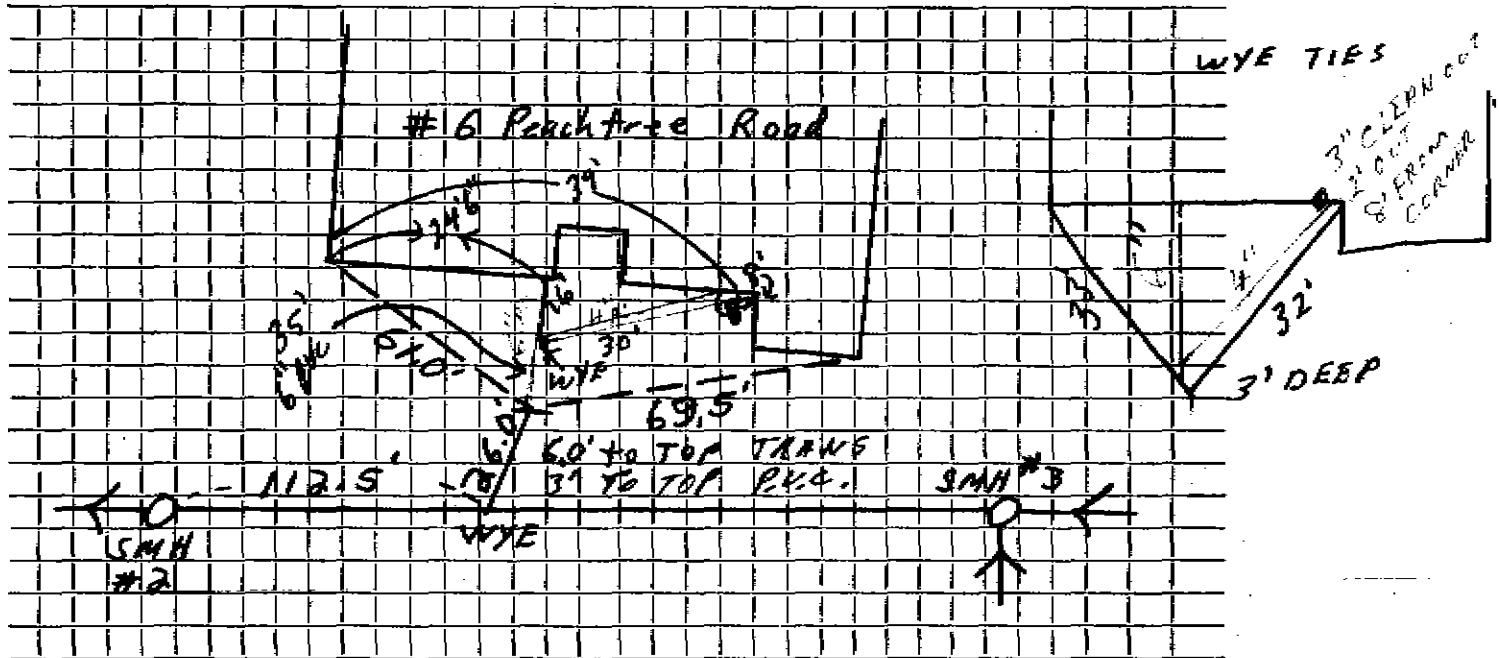

Connection made in Peachtree Street. Work completed

Remarks:

.....

.....