




DATE MAY 1984

TOWN OF LEXINGTON — BOARD OF PUBLIC WORKS

SEWER DIVISION

Sketch of Service Here

7

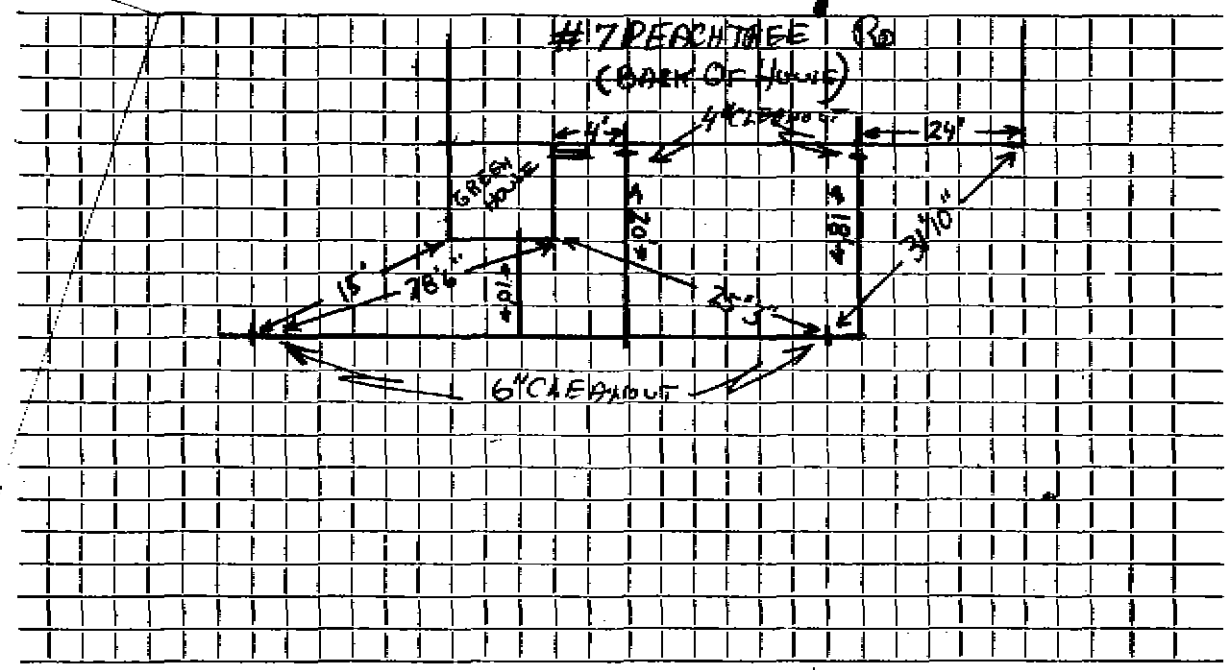

Connection made in APPLE STATE Street. Work completed MAY 10, 1984

Remarks: Repair Made 01-05-01 @ Cast Iron to PVC Connection