

Name Susan Loring

Service No.

128 (75)

Address 8 Peachtree Road

8 Peach Tree Road

Location

Kind of Pipe AC

Size 6"

Size of Main 8"

Repair—Renewal—New Service

Lexington Sewerage #2925

Location

AUG 16 1978


Date	Material	Amount	Total	Date	Amount
<del>5-25-75</del>	<del>26' 6" AG at</del>	<del>10.00</del>	=	11-4-5	Deposit 260 00
1/7/75	48' 6" Transite Pipe				
	10' 4" Cast Iron Pipe			6-25-75	
					26' 6" Transite
					1 6" x 8" Wye

DATE \_\_\_\_\_

TOWN OF LEXINGTON — BOARD OF PUBLIC WORKS

SEWER DIVISION

Sketch of Service Here **8**

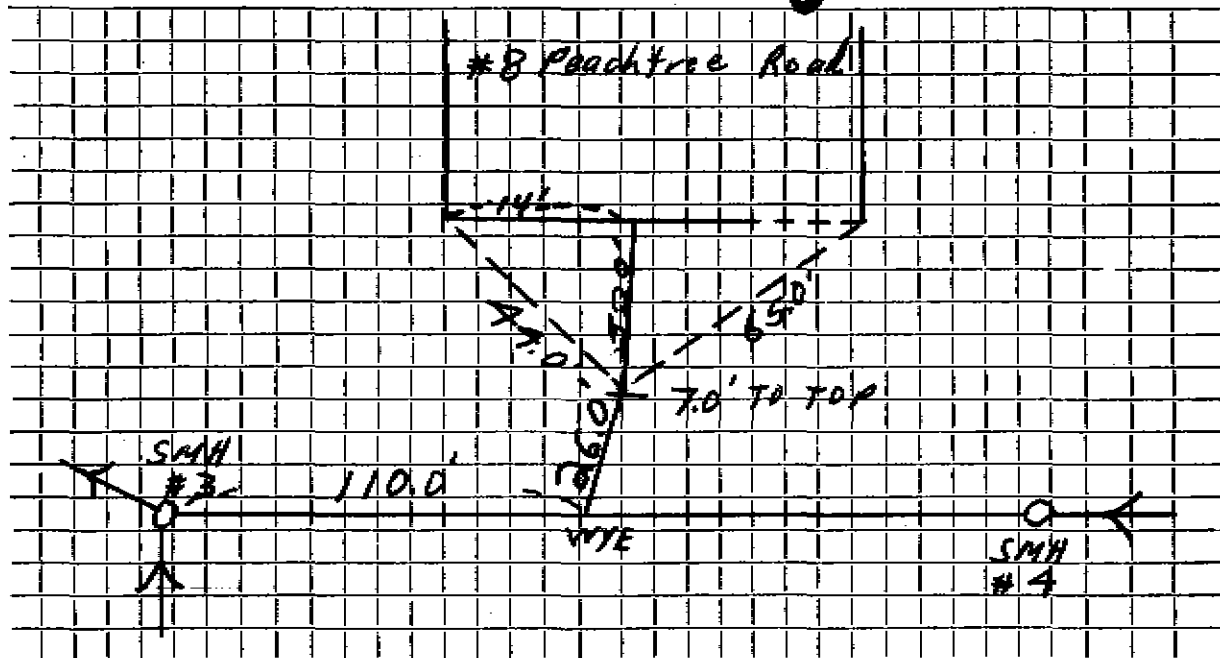

Connection made in Peachtree Lane Street.

Work completed 11/7/75

Remarks: .....

.....

.....