




DATE 3/2018

TOWN OF LEXINGTON — BOARD OF PUBLIC WORKS  
SEWER DIVISION

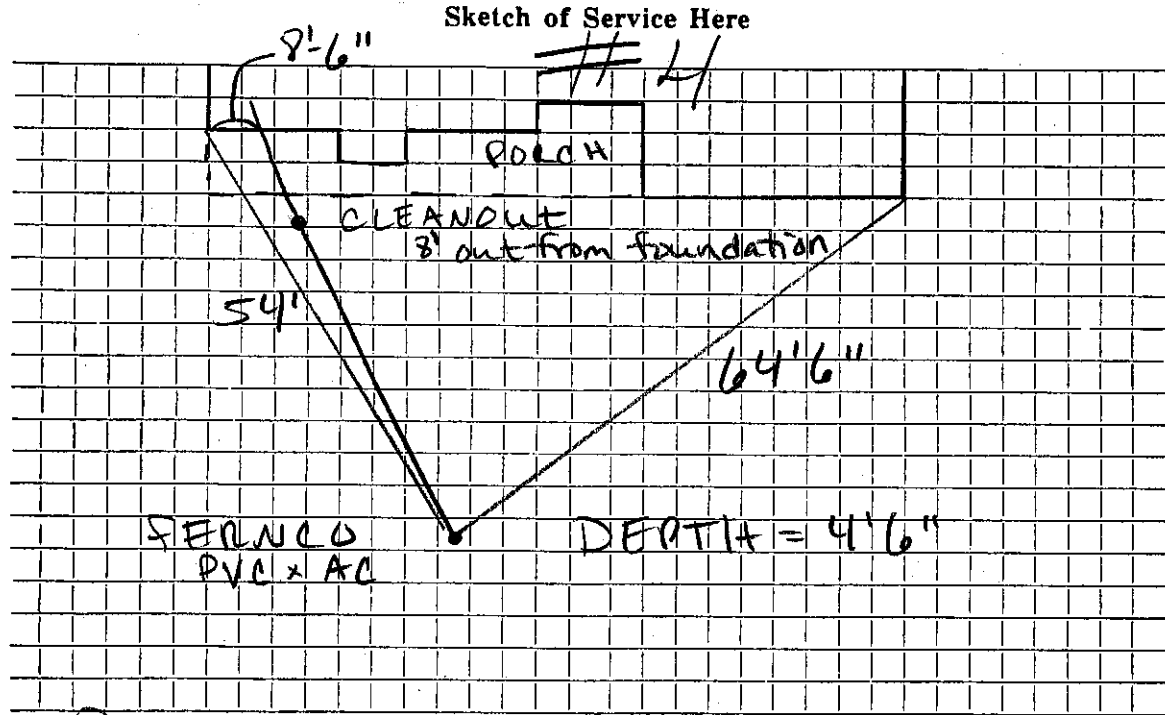

Connection made in Peachtree Street. Work completed .....

Remarks: taken from JM McLaughlin's tier