

DATE _____


TOWN OF LEXINGTON — BOARD OF PUBLIC WORKS

SEWER DIVISION

Sketch of Service Here

15

Pegcock Farm Rd

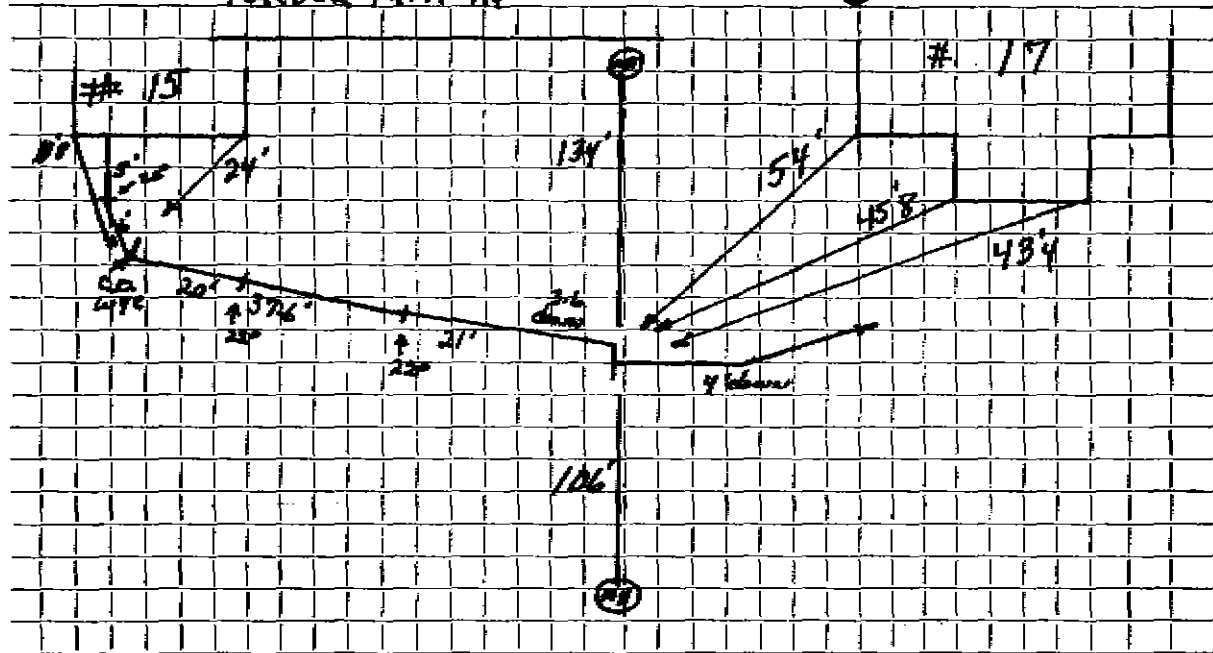

Connection made in East Street. Work completed

Remarks: Bathroom on lower level is not connected to sewer.