

Daniel J. Fink

Service No. 67

Address 17 Peacock Farm Rd.

17 Peacock Farm Rd.

Location

Kind of Pipe

Size 6"

Size of Main 8"

~~Peacock Farm Rd.~~ New Service

Location *Conn 7-5-60*

Date	Material	Amount	Total	Date	Amount
5-60	Labor	22.26		1-6-60	Deposit
7-60	"	60.42	82 68	2-5-60	Retained
	10 % O.H.	8 27	90 95		165 90
50'	6" Transite Pipe @ .70		35 00		
1	22 1/2" Transite Elbow		2 24		
1	22 1/2" Transite Bend		6 21		
3	Hrs. Town Shovel @ 6.50		19 50		
3	Hrs. Trucking @ 3.00		9 00		
1	Hr. Trailer @ 3.00		3 00		
			165 90		


DATE _____

TOWN OF LEXINGTON — BOARD OF PUBLIC WORKS

SEWER DIVISION

Sketch of Service Here
Peacock Farm Rd

17

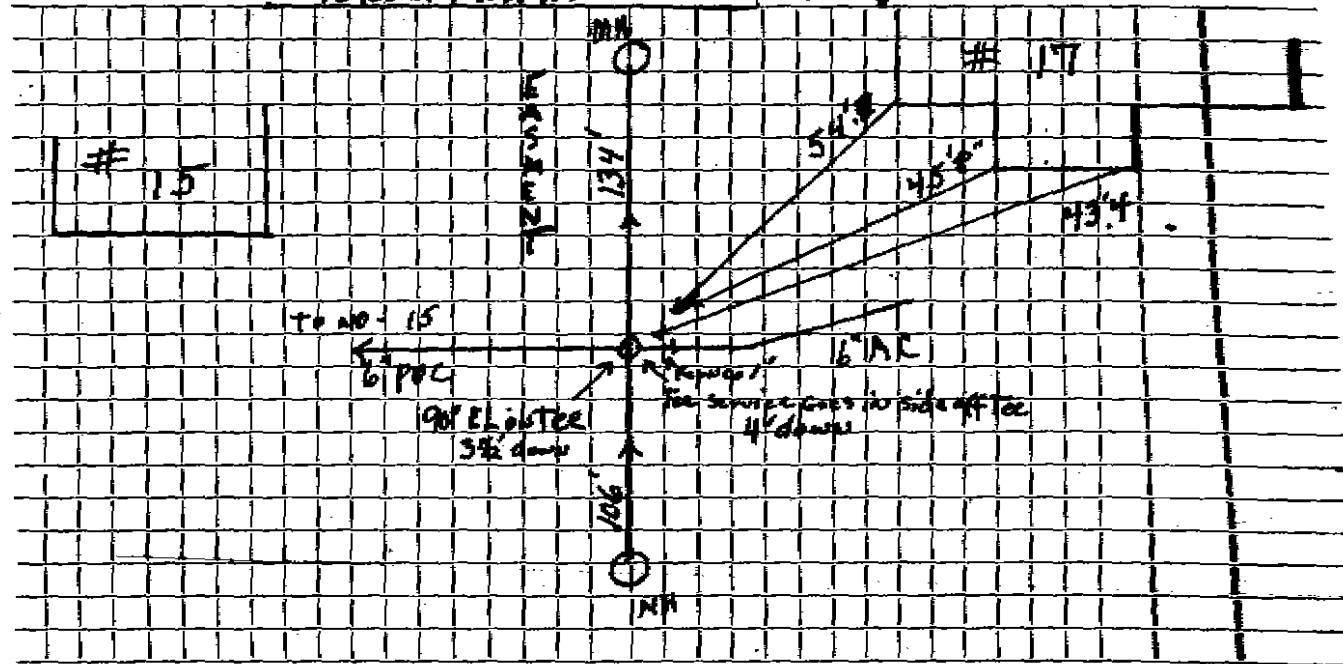

Connection made in Essex Street. Work completed

Remarks: Service Bunker, tee on top of chimney for both service's