

Don J. ...

Service No. 182

Address W/S Peacock Farm Rd.

8 Peacock Farm Rd.

Kind of Pipe

Size 6"

Size of Main 8"

New Service

Watt 8309

Location JUN 29 1964

Date	Material	Amount	Total	Date	Amount
-64	LABOR	87.72		4-14-63	Deposit
	10% O.H.	8.77	96.49	4-29-64	Retained
58	6" Transite pipe	8.82	47.56		
1	90° Transite Elbow		4.09		
1	6" Duplex Adapter		1.62		
1	11 1/2" Transite Bend		4.09		
1	11 1/2" Transite Elbow		2.35		
1	BAG Cement		1.50		
5	Excavation	66.50	32.50		
2	Excavation	33.00	6.00		
			196.20		


DATE _____

TOWN OF LEXINGTON — BOARD OF PUBLIC WORKS

SEWER DIVISION

Sketch of Service Here

18

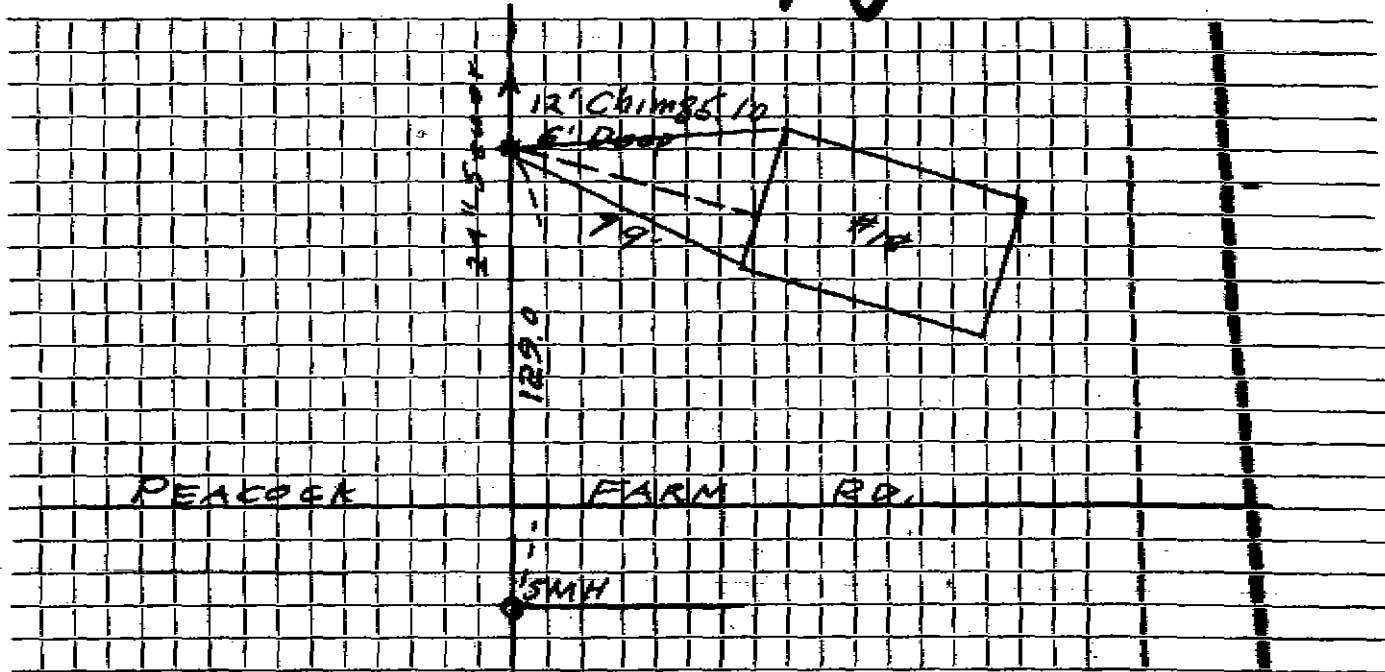

Connection made in Street. Work completed

Remarks:
.....
.....