

Name Joseph Berman

Service No. 25036 <sup>74</sup>

Address # 2 Peacock Farm Rd.

2 Peacock Farm Rd.

Location

Kind of Pipe A.C.

Size 6"

Size of Main 8"

Repair—Renewal—New Service

Suburbanite Cesspool Service #248


Location MAR 27 1978

Date	Material	Amount	Total	Date	Amount
5-29-74	25' - 4" C.I.			5-13-74	350.00
	96' - 6" ACP			5-17-74	600.00
1974	Install service		950.00		950.00
					35' 6" Transite

TOWN OF LEXINGTON — BOARD OF PUBLIC WORKS

SEWER DIVISION

Sketch of Service Here **2**

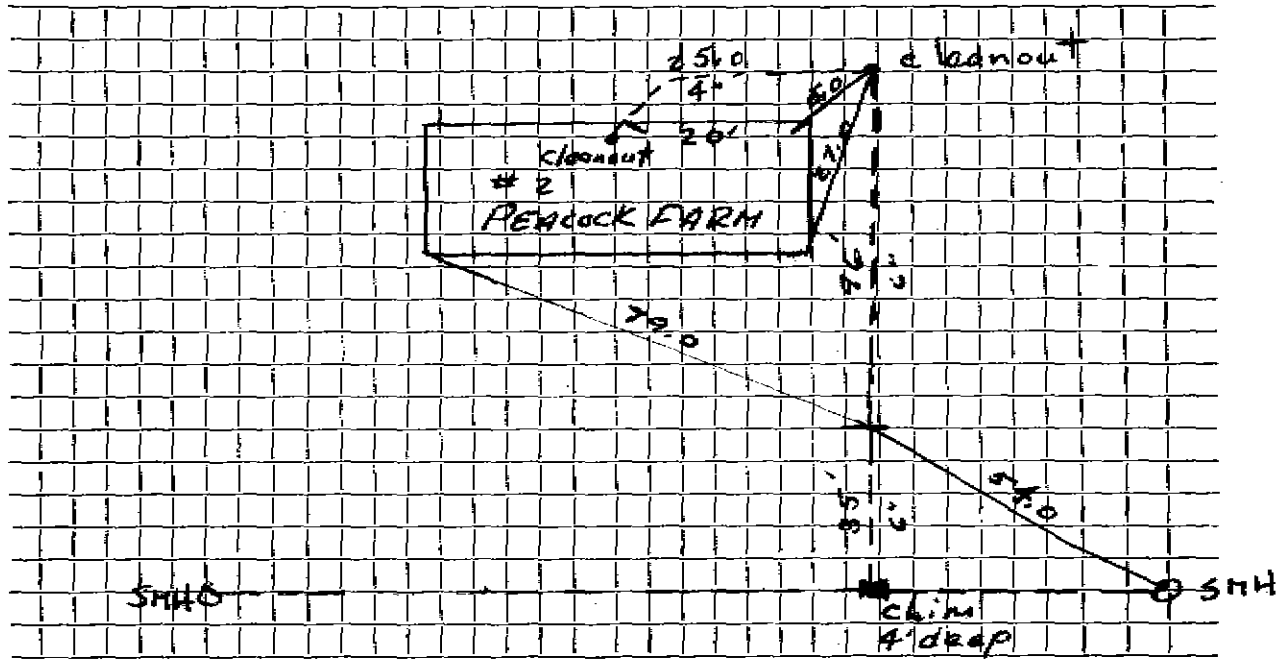

Connection made in ..... Street. Work completed .....

Remarks: .....

.....

.....