

Name Dennis Slone

Service No. 18

Address 22 Peacock Farm Road

22 Peacock Farm Rd.

Location 22 Peacock Farm Road

Kind of Pipe Valeri Const. Permit #A192

Size 6"

Size of Main 8"

~~REPLACEMENT~~ New Service


Location MAY 2 1966

Date	Material	Amount	Total	Date		Amount
	Corner lot 2 services charge for the one they will connect to and disregard the other one			3-5-66	Deposit	147.00
	21' @ 7.00 per foot installed by contractor		147.00			
3-66	38.5' 6" Transite pipe					
	<del>21.5 feet 6" A.C. installed by contractor @ 6.00 per foot</del>					129.00
	21' @ 6.17					

DATE \_\_\_\_\_

TOWN OF LEXINGTON — BOARD OF PUBLIC WORKS

SEWER DIVISION

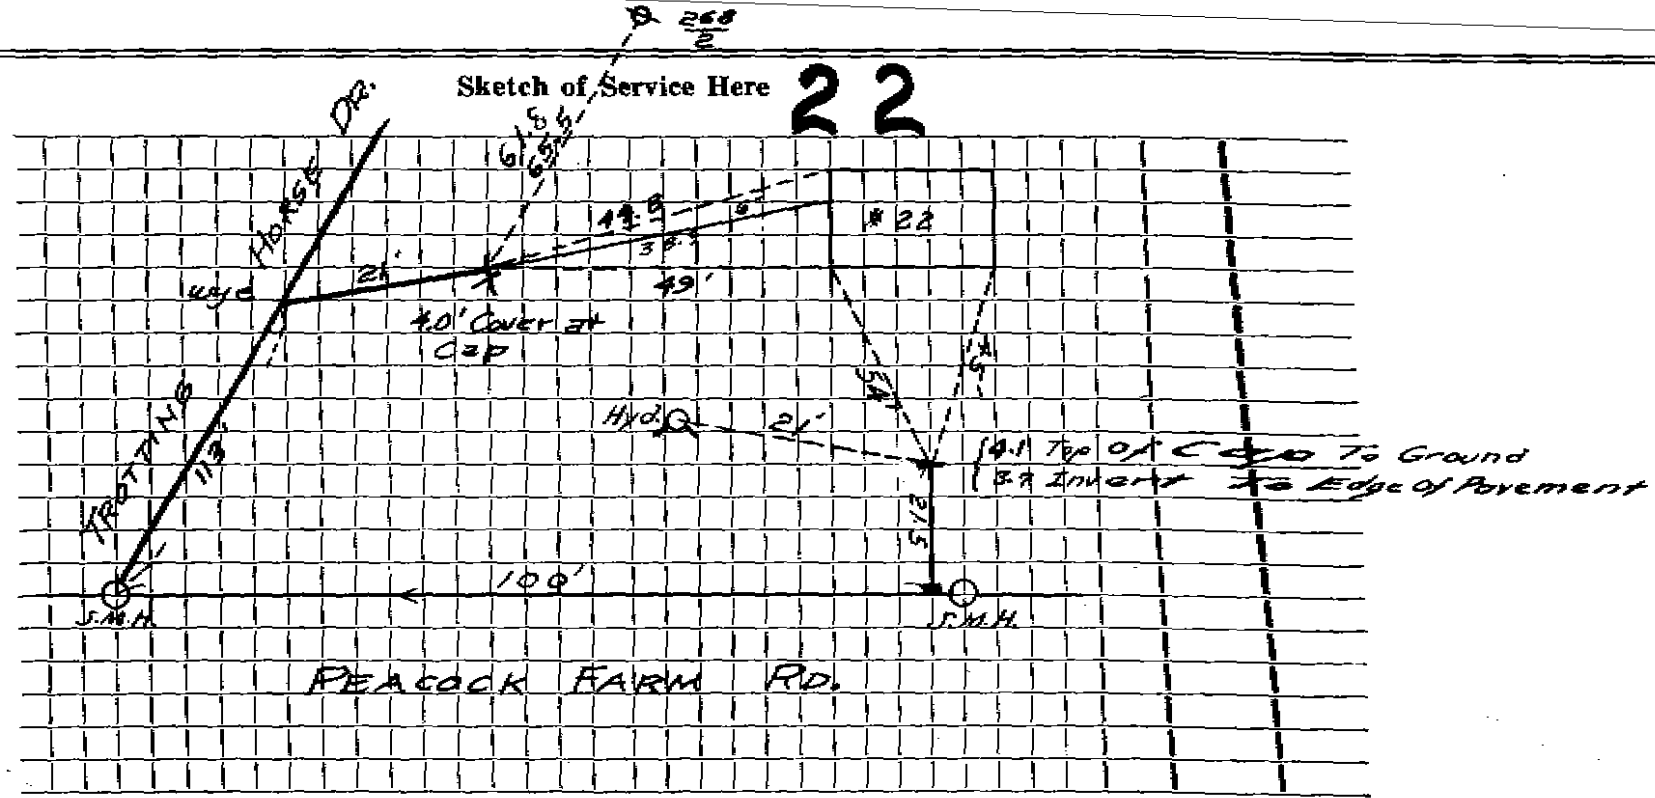

Connection made in ..... Street. Work completed .....

Remarks: .....  
.....  
.....