

Name **Alvin L. Schmertzler**

Service No. **13**

Address **23 Peacock Farm Road**

Location **23 Peacock Farm Road**

23 Peacock Farm Rd.

Kind of Pipe

Size **6"**

Size of Main **8"**

~~RENEWAL~~ **New Service**

wo # **8566**

Location **JUN 29 1964**

Date	Material	Amount	Total	Date	Amount
-64	Labor	116.29		2-25-64	225.00
	10% O.H.	11.63	127.92	11-6-64	53.76
	40' 6" Transite pipe @.82		32.80		328.76
2	Duplex Adapter @1.62		3.24		
1	6 x 6 Transite Y		4.09		
2	11 1/4° Bends @4.09		8.18		
1	22 1/2° Bend		4.09		
1	Cesspool Cover & Frame		10.50		
1	Bag Cement		1.50		16.5 feet 6" A.C.
1	ton Sand @1.00		1.10		installed by contractor
20	Brick @4.20 per 100		.84		@ 6.00 per foot
5	yds. Loam @2.00		10.00		99.00
3	hrs. Town Shovel @6.50		19.50		
2	hrs. Trucking @3.00		6.00		
	Previous Charge		99.00		
			328.76		Bill sent 53.76


DATE _____

TOWN OF LEXINGTON — BOARD OF PUBLIC WORKS

SEWER DIVISION

Sketch of Service Here

23

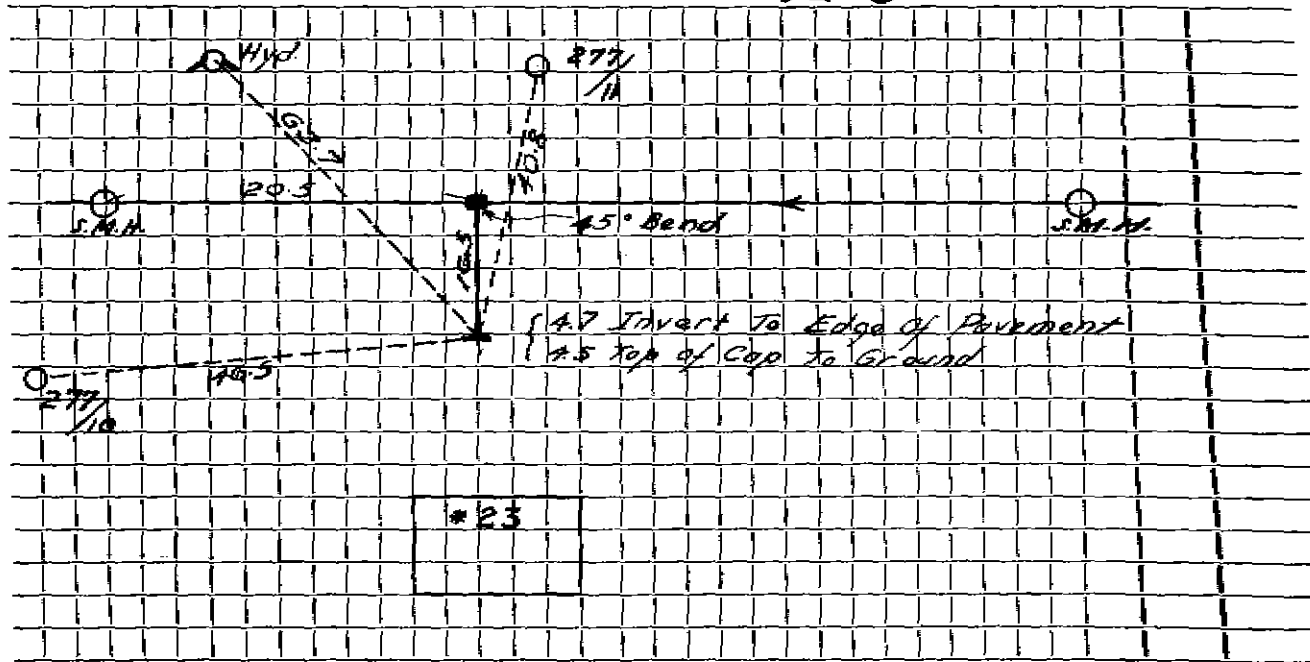

Connection made in Street. Work completed

Remarks:


.....

.....

DATE _____

TOWN OF LEXINGTON — BOARD OF PUBLIC WORKS
SEWER DIVISION

Sketch of Service Here

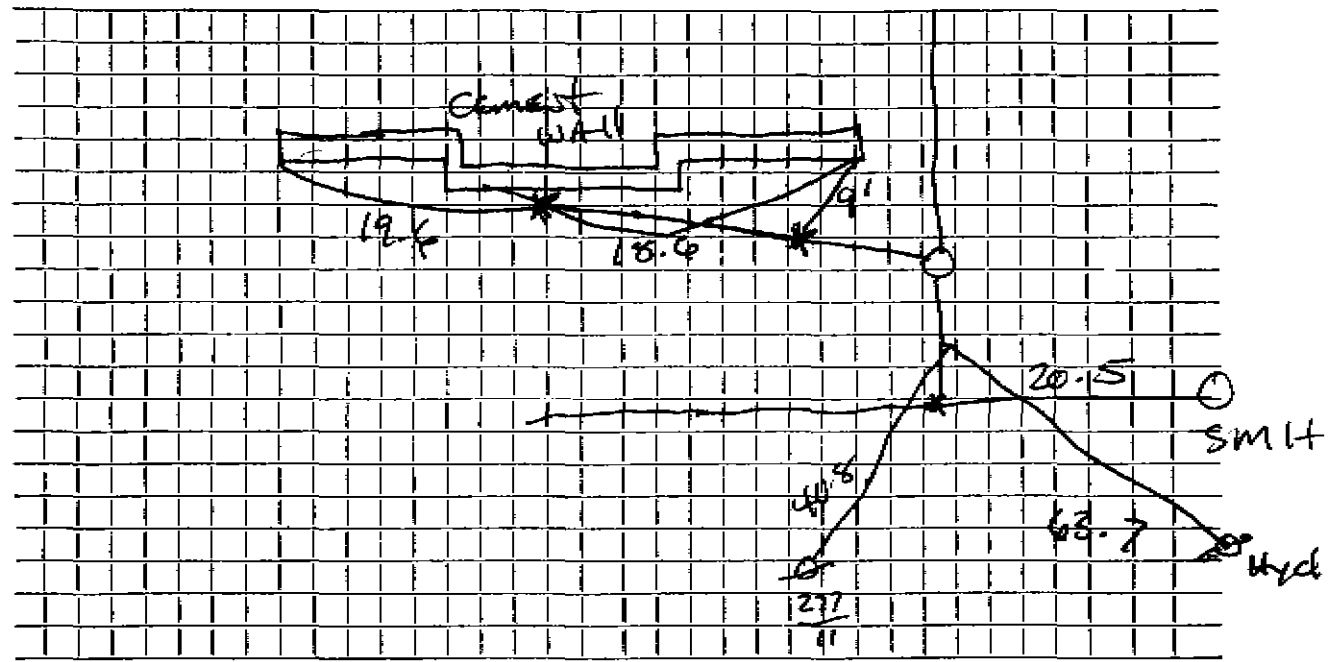

Connection made in Street. Work completed

Remarks:
Repair made 11:27:00
.....