

Name *William Karjane*

Service No. *87*

Address *25 Peacock Farm Road*

*25 Peacock Farm Rd.*

Location

Kind of Pipe

Size *6"*

Size of Main *8"*

~~Repair~~ ~~Renewal~~ ~~New Service~~

*W.O. 5595 S*  
*Ralph Gurianello #3004*

Location

DEC 12 1977

Date	Material	Amount	Total	Date	Amount	
<i>7/29/77</i>	<i>33' 6" transite</i>			<i>7-23-77</i>	<i>Deposit</i>	<i>250.00</i>
	<i>10' 4" cast iron</i>			<i>3-27-78</i>	<i>Paid</i>	<i>16.13</i>
<i>7/26/77</i>	Labor	128 70		<i>7-26-77</i>		<i>266.13</i>
	10% O.H.	12 87	141 57		<i>10' 6" Transite</i>	
	<del>10' 6" Transite @ 1.51</del>		15 10		<i>1 6" X 6' Nipple</i>	
	<del>1 5' x 6" Nipple @ 1.76</del>		8 80			
	<i>1/2 Bsg Cement</i>		1 63			
	<del>1 6" Cap</del>		5 10			
	<i>1 Ton Cold Patch</i>		13 25			
	<i>2 Hrs. Town Shovel @ 6.50</i>		13 00			
	<i>3 Hrs. Trucking @ 3.00</i>		9 00			
	<i>Hot Top 8'x11'</i>		58 68			
			266 13			


TOWN OF LEXINGTON — BOARD OF PUBLIC WORKS

SEWER DIVISION

DATE \_\_\_\_\_

Sketch of Service Here

25

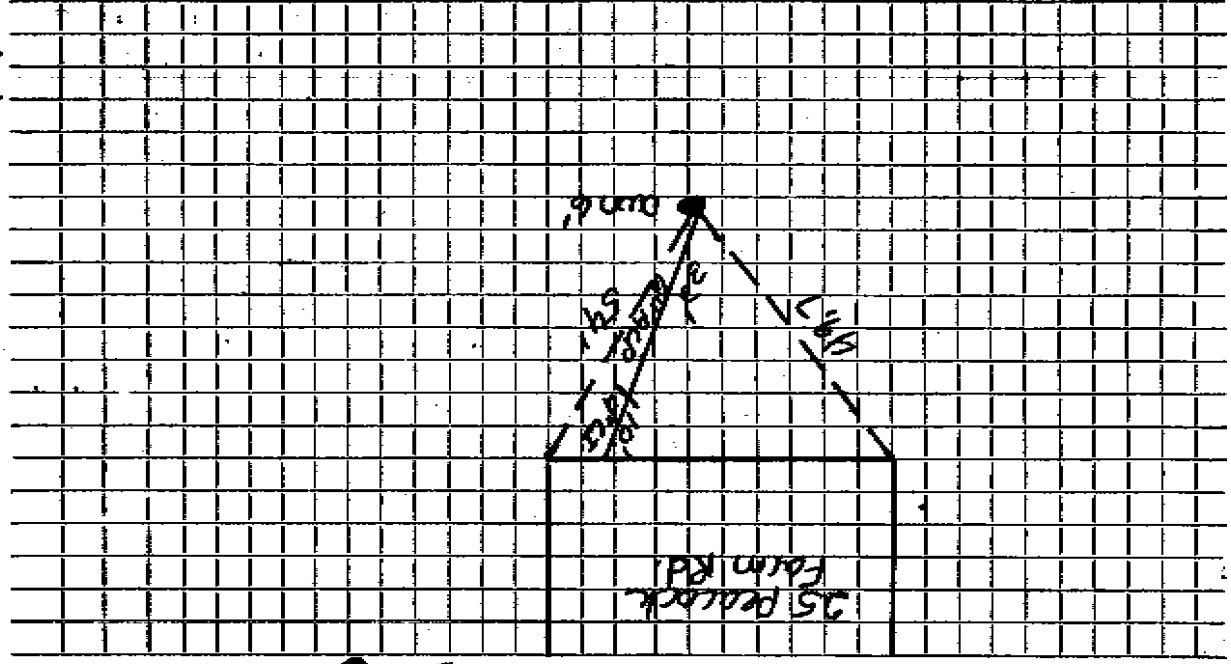

Connection made in \_\_\_\_\_ Street.

Work completed \_\_\_\_\_

01

Remarks: \_\_\_\_\_