

Name **Barney Reiffen**

Service No. 180

Address 26 Peacock Farm Road

26 Peacock Farm Rd.

Location 26 Peacock Farm Road

Kind of Pipe

Size **6"**Size of Main **8"**~~New Service~~ — New Service

W. # 8306

Location


JUN 20 1964

Date	Material	Amount	Total	Date	Amount	
-22-64	Labor	42.96		11-13-63	Deposit	325.00
-26-64	"	31.09	97.45	6-29-64	Retard	17.99
	10% O.E.	9.75	107.20			357.61
	66' 6" Transite pipe @.82		54.12			
	2 22½° Transite Bend @4.09		8.18			
	1 11¼° Transite Bend		4.09			
	2 22½° Transite Elbow @2.35		4.70			
	1 6" Adapter		1.62			
	1 bag Cement		1.50			
	8 yds. Loan @2.00		16.00			
	Fertilizer & Lime		1.50		21.6 feet 6" A.C.	
	3 hrs. Town Shovel @6.50		19.50		installed by contractor	
	3 hrs. Trucking @3.00		9.00		@ 6.00 per foot	129.60
	Previous Charge		129.60			
			357.01			

DATE _____

TOWN OF LEXINGTON — BOARD OF PUBLIC WORKS
SEWER DIVISION

Sketch of Service Here **26**

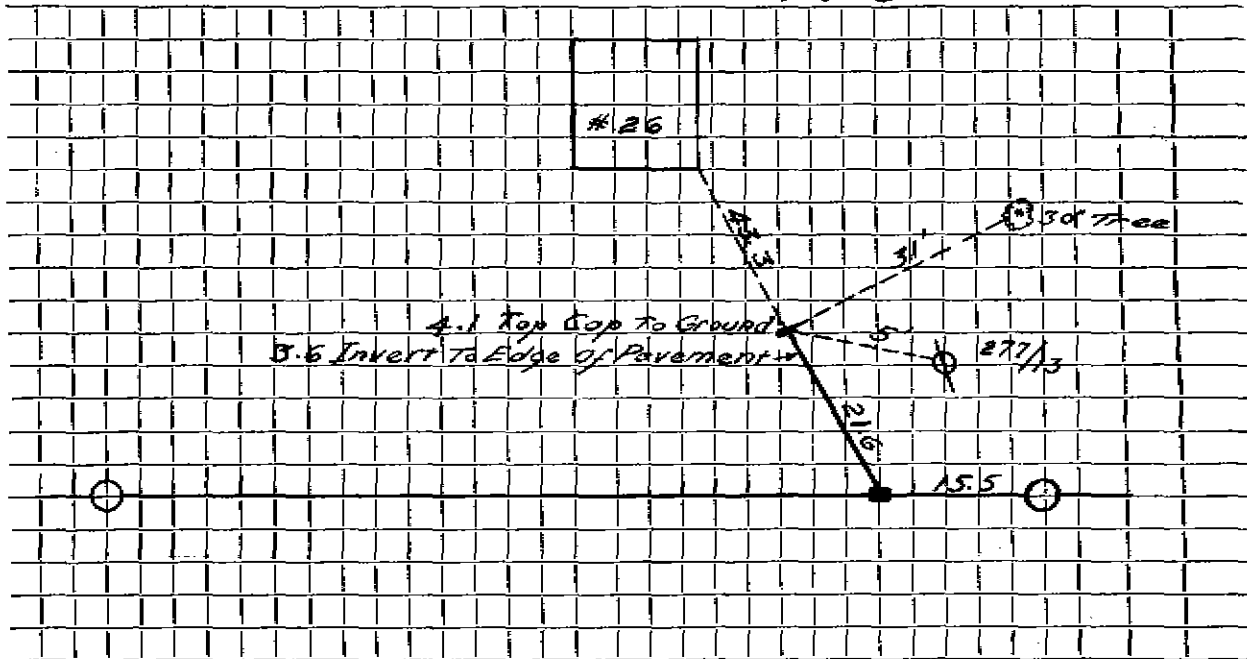

Connection made in Street. Work completed

Remarks:
.....
.....