

Name **Martin A. Abkowitz**

Service No.

198

Address **28 Peacock Farm Road****28 Peacock Farm Rd.**Location **28 Peacock Farm Road**

Kind of Pipe

Size **6"**Size of Main **8"**~~Revised Estimate~~ **New Service**

W 02F 8.338

Location **JUN 29 1964**


Date	Material	Amount	Total	Date	Amount
26-63	Labor	31.79		11-22-63	436 00
27-63	"	77.73			
6-64	"	15.47		6-29-64	34 70
7-64	"	11.70	136.69		395 38
	10% O.H.	13.67	150.36		
67*	6" Transite pipe @.82		54.96		
2	22 1/2° Transite bends @4.09		8.18		
2	11 1/2° Transite Elbows @2.35		4.70		
1	Duplex Adapter		1.62		
1	bag Cement		1.50		
8	yds. Loam @2.00		16.00		
	Lime & Fertilizer		3.00		
4	hrs. Town Shovel @6.50		26.00		
4	hrs. Trucking @3.00		12.00		
	Previous Charge		117.00		19.5 feet 6" A.C. installed by contractor
			395.30		@ 6.00 per foot
					117 00

DATE _____

TOWN OF LEXINGTON — BOARD OF PUBLIC WORKS

SEWER DIVISION

Sketch of Service Here **28**

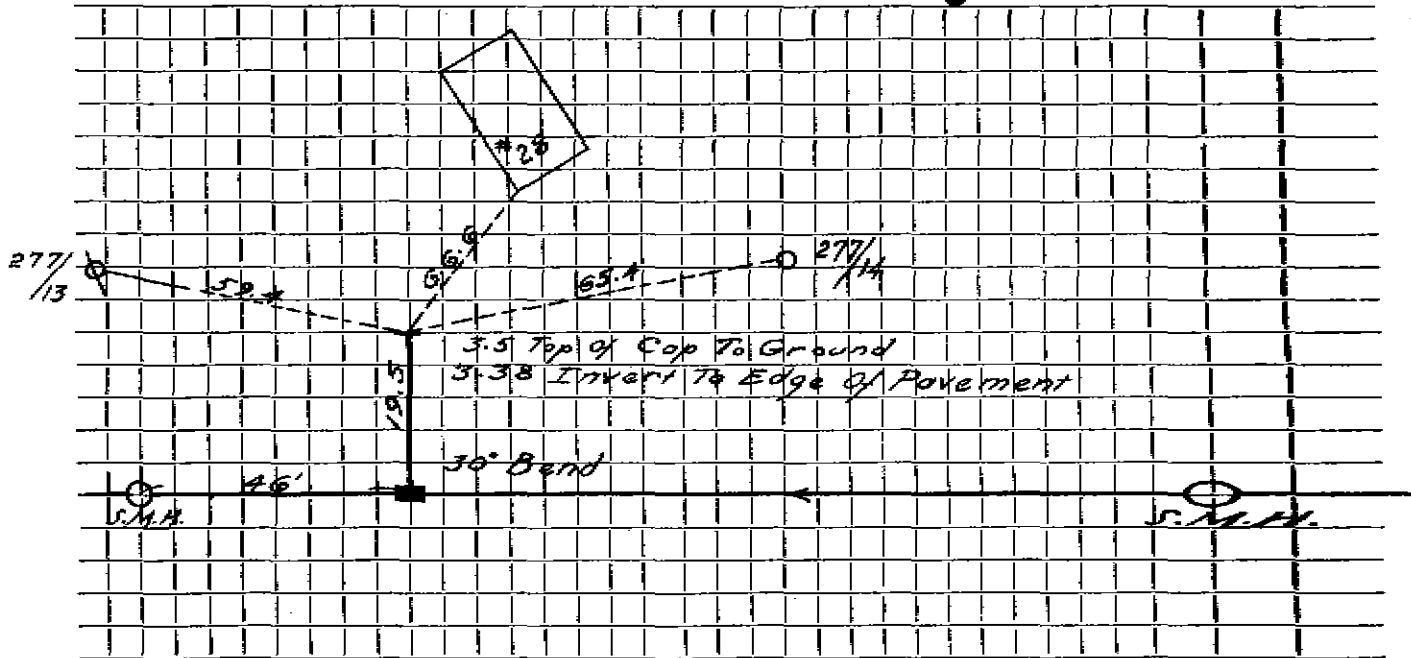

Connection made in Street. Work completed

Remarks:
.....
.....