

Name Peacock Farm Assoc. (Pool)

Service No.

Address 29A Peacock Farm Road

29A Peacock Farm Rd.

Location

Kind of Pipe

Size 6"

Size of Main 8"

Repair—Renewal—New Service

Valeri Const. #1570

Location

Date	Material	Amount	Total	Date	Amount
-1-70	186'	6" Transite pipe			
11-19-	91				
	5' 6"	P.V.C.			
	4' 4"	P.V.C.			
	3' 3"	Copper			
	1	4" - 45° Bend			
	1	6" - 90° Bend			
	1	3" x 4" Fernco			
	1	4" x 6" Fernco			
	1	6" x 8" Wye			

TOWN OF LEXINGTON — BOARD OF PUBLIC WORKS
SEWER DIVISION


DATE _____

← Waterdown Street →

Sketch of Service Here

29A

29A Peacock Farm Road

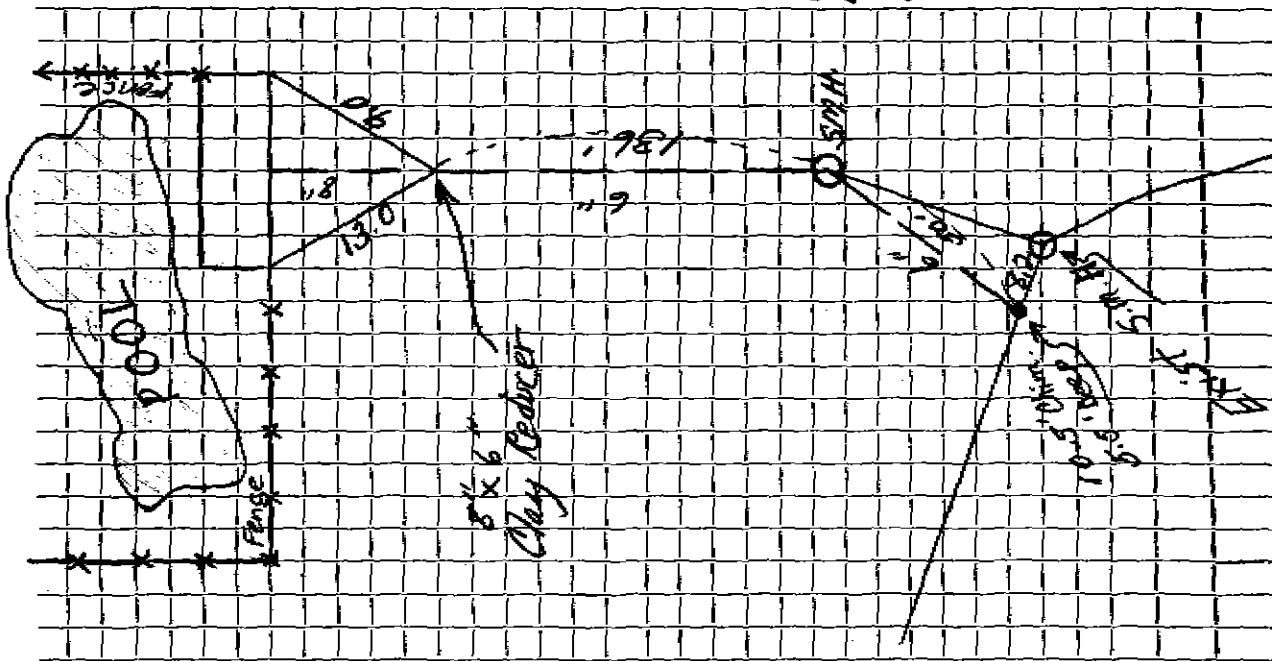

Connection made in Street. Work completed

Remarks:

.....

.....