

Name Henryk Hurvics

Service No. 153

Address 29 Peacock Farm Road

29 Peacock Farm Rd.

Location 29 Peacock Farm Road

Kind of Pipe

Size 6"

Size of Main 8"

~~Repair Renewal~~—New Service W.O. #9217


Location FEB 15 1965

Date	Material	Amount	Total	Date	Amount
26-64	Labor	87.17		9-9-64	Deposit 300.00
28-64	Labor	80.95		3-10-65	Paid 14.68
29-64	Labor	18.68	186.80	4-11-65	Paid 69.00
	10% O.H.	18.68	205.48		383.68
35'	6" Transite Pipe @ .82		28.70		
11	Ton Stone @ 1.50		16.50		
8	Hrs Town Shovel @ 6.50		52.00		
4	Hrs Town Truck @ 3.00		12.00		
			314.68		
					11.5 feet 6" A.C. installed by contractor @ 6.00 per foot 69.00
					Bill sent 83.68

DATE _____

TOWN OF LEXINGTON — BOARD OF PUBLIC WORKS
SEWER DIVISION

Sketch of Service Here **29**

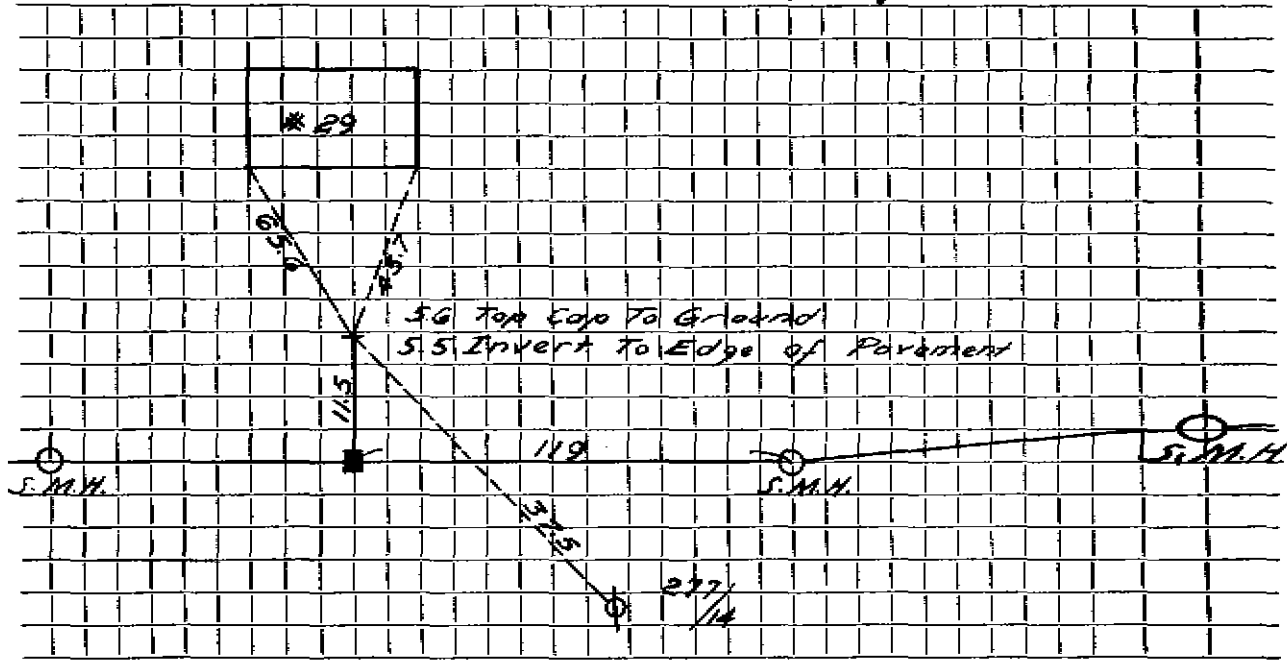

Connection made in Street. Work completed

Remarks:
.....
.....