

Name **Bernhart R. Snyder**

Service No. 197

Address 30 Peacock Farm Road

30 Peacock Farm Rd.

Location 30 Peacock Farm Road

Kind of Pipe

Size 6"

Size of Main 8"

~~Revised Estimate~~ - New Service w/ off 8.33%Location *Comm 5-18-64*

Date	Material	Amount	Total	Date	Amount
26-63	Labor 43.34			11-21-63	Deposit 260 00
4-64	" 18.56	61.90		8-20-64	Paid 47 08
	10% O.R.	6.19	68.09		
34'	6" Transite pipe @.82		27.88	11-13-64	Abate <u>6 00</u>
1	11 1/4° Transite Elbow		2.35		313 08
1	22 1/2° Transite Elbow		2.35		
1	22 1/2° Transite Bend		4.09		
1	6 x 12 Nipple		1.65		
1	6" Adapter		1.62		
1	bag Cement		1.55		26.5 feet 6" A.C.
6	yards Loam @3.00		18.00 24.00		installed by contractor
	Line & Fertilizer		1.50		@ 6.00 per foot 159 00
2	hrs. Town Shovel @6.50		13.00		
2	hrs. Trucking @3.00		6.00		
	Previous Charge		159.00		
			313.08		


Bill 501 308

DATE _____

TOWN OF LEXINGTON — BOARD OF PUBLIC WORKS

SEWER DIVISION

Sketch of Service Here **30**

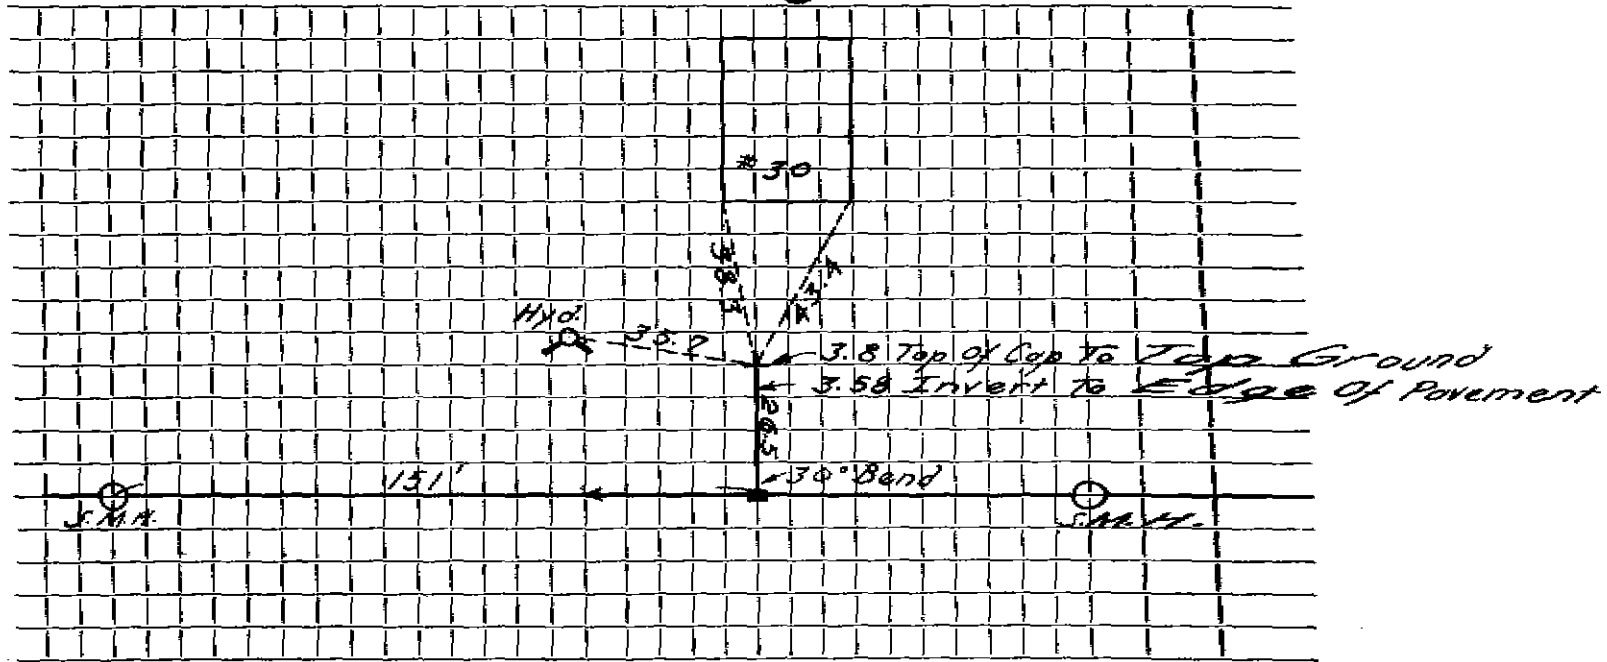

Connection made in Street. Work completed

Remarks:

.....

.....