

Name Irvin GoldsteinService No. 206Address 31 Peacock Farm RoadLocation 31 Peacock Farm Road31 Peacock Farm Rd.

Kind of Pipe

Size 6"Size of Main 8"~~Water Mains~~ New ServiceW OFF 83.55

Location

Comm 5-18-64

Date	Material	Amount	Total	Date	Amount
1-29-63	Labor	56.32		11-29-63	230.00
2-2-63	"	19.54		6-26-64	40.52
4-64	"	24.75	100.61		270.52
	10% O.H.	10.06	110.67		
	36' 6" Transite pipe @.82		29.52		
	1 6 x 6 Transite "Y"		4.09		
	2 22 1/2" Transite bend @4.09		8.18		
	2 6" Duplex Adapter @1.62		3.24		
	1 6 x 6 Nipple		1.65		
	1 bag cement		1.55		12.0 feet 6" A.C.
	2 3/4 ton 1 1/2" Stone @1.50		4.12		installed by contractor
	4 yards Loam @3.00		12.00		@ 6.00 per foot
	Lime & Fertilizer		1.50		
	3 hrs. Trucking @3.00		9.00		
	2 hrs. Town Shovel @6.50		13.00		
	Previous Charge		72.00		
			270.52		


bill sent 4.52

DATE _____

TOWN OF LEXINGTON — BOARD OF PUBLIC WORKS
SEWER DIVISION

Sketch of Service Here

31

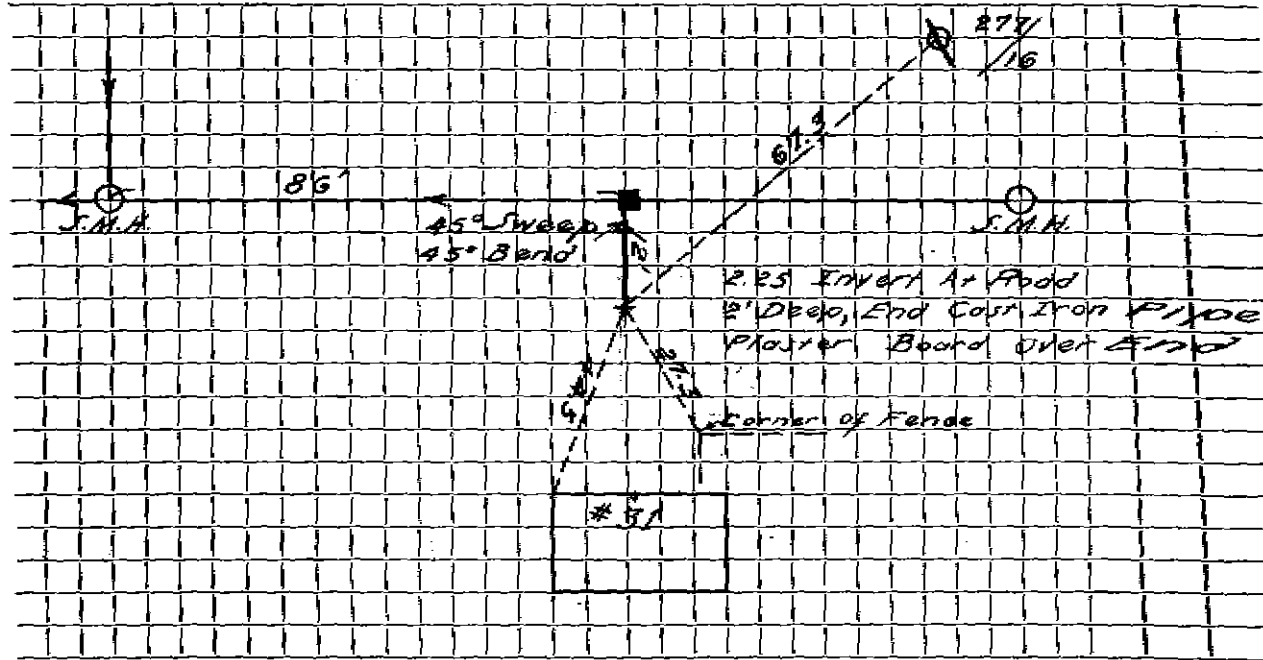

Connection made in Street. Work completed

Remarks:

.....
.....