

Name Stanley Gruber

Service No. 181

Address 32 Peacock Farm Road

32 Peacock Farm Rd.

Location

Kind of Pipe

Size 6"

Size of Main 8"

~~REPAIR FUNDING~~ New Service

Work # 2327

Location JUN 29 1964


Date	Material	Amount	Total	Date	Amount
-29-63	Labor	65.70		11-13-63	Deposit 230 00
7-64	"	23.40	89 10	6-29-64	Retund 59 93
	10% O.H.	8 91	98 01		176 07
48'	6" Transite pipe @.82		39 36		
2	11 1/2" Transite Elbows @2.35		4 70		
1	Bag Cement		1 50		
3	Yards Loam @2.00		6 00		
	Lime & Ferlizer		1 50		
2	Hrs. Trucking @3.00		6 00		
2	Hrs. Town Shovel @6.50		13 00		
			170 07		

DATE _____

TOWN OF LEXINGTON — BOARD OF PUBLIC WORKS
SEWER DIVISION

Sketch of Service Here

32

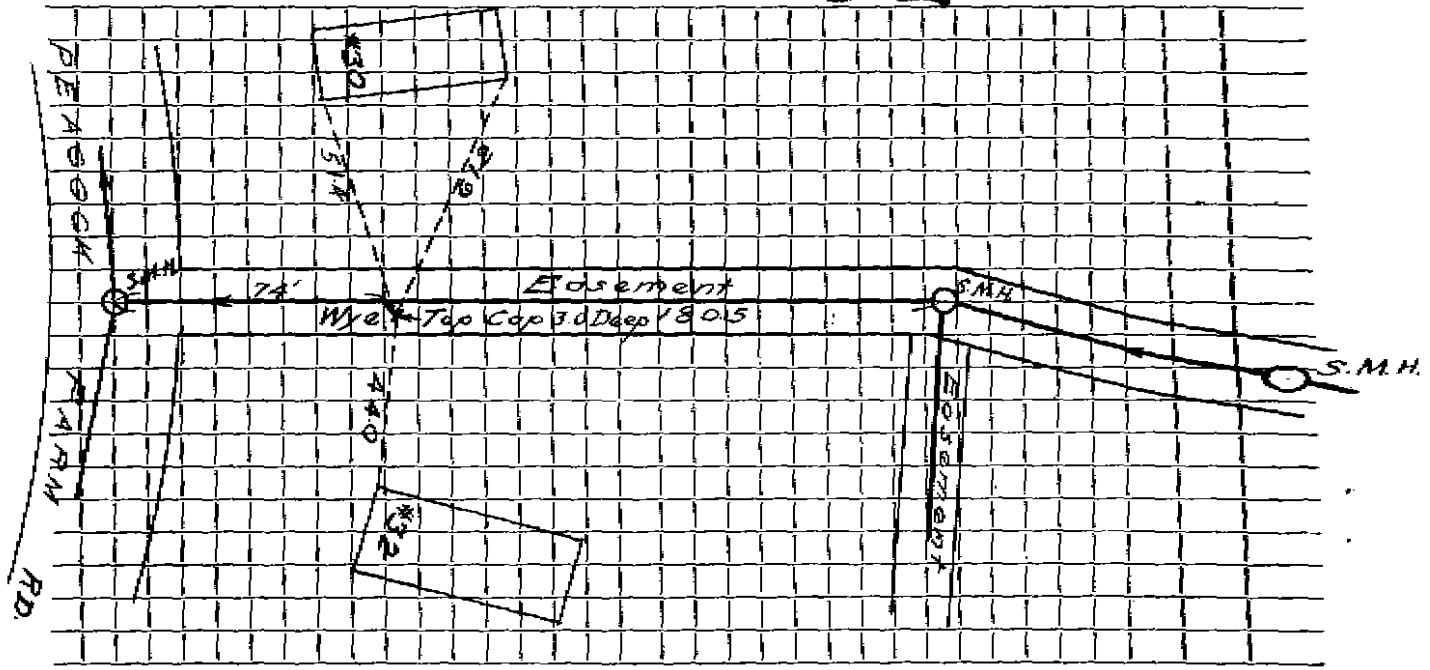

Connection made in Street. Work completed

Remarks:

.....