

Name Franklin D. HolzmanService No. 176Address 33 Peacock Farm Road33 Peacock Farm Rd.Location 33 Peacock Farm Road

Kind of Pipe

Size 6"Size of Main 8"~~RENEWAL~~ New ServiceW.O.# 8301

Location

Perm 5-18-64

Date	Material	Amount	Total	Date	Amount
1-21-63	Labor 14.48			11-12-64	360.00
1-22-63	" 81.15			12-7-64	29.24
4-64	" 18.56	114.19			389.24
	10% O.H.	11.42	125.61		
	44' 6" Transite pipe @.82		36.08		
1	11 1/2° Transite Elbow		2.35		
1	22 1/2° Transite Elbow		2.35		
1	bag Cement		1.55		
6	yards Loam @3.00		24.00		
	Line & Fertiliser		1.50	12-26-79	26.8 feet 6" A.C.
4	hrs. Town Shovel @6.50		26.00		installed by contractor
3	hrs. Trucking @3.00		9.00		@ 6.00 per foot
	Previous Charge		160.80		160.80
			389.24		


Bill sent 2/26

DATE _____

TOWN OF LEXINGTON — BOARD OF PUBLIC WORKS
SEWER DIVISION

Sketch of Service Here

33

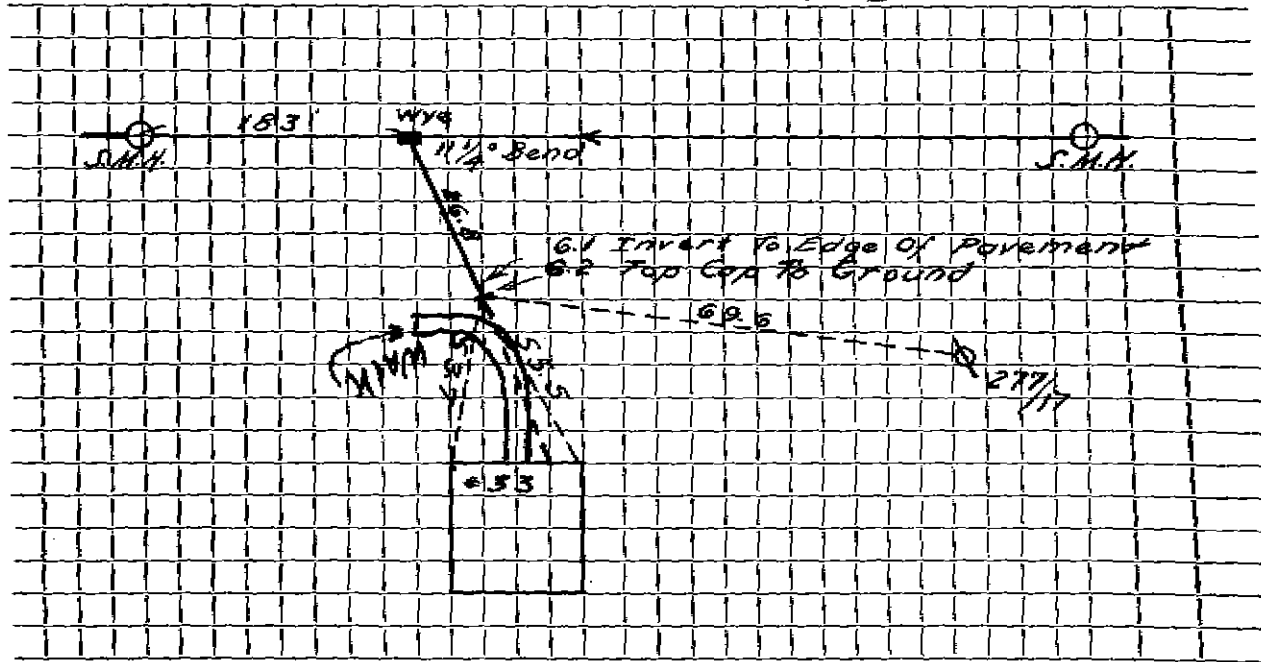

Connection made in Street. Work completed

Remarks: SERVICE RUNS UNDER CEMENT WALK. PROPERTY!!
... 1.5' 4.9" FROM EDGE OF STAT. TO S.