

Name **Bertram Fig**

Service No. **178**

Address **34 Peacock Farm Road**

34 Peacock Farm Rd.

Location **34 Peacock Farm Road**

Kind of Pipe

Size **6"**

Size of Main **8"**

~~Repair~~ **New Service** Valeri Const. Co. - Permit #148

Location **DEC 28 1964**


Date	Material	Amount	Total	Date		Amount
-3-64	117' 6" Transite pipe			12-30-64	Deposit	160 80
					26.8 feet 6" A.C. installed by contractor @ 6.00 per foot	160 80

DATE _____

TOWN OF LEXINGTON — BOARD OF PUBLIC WORKS

SEWER DIVISION

Sketch of Service Here **34**

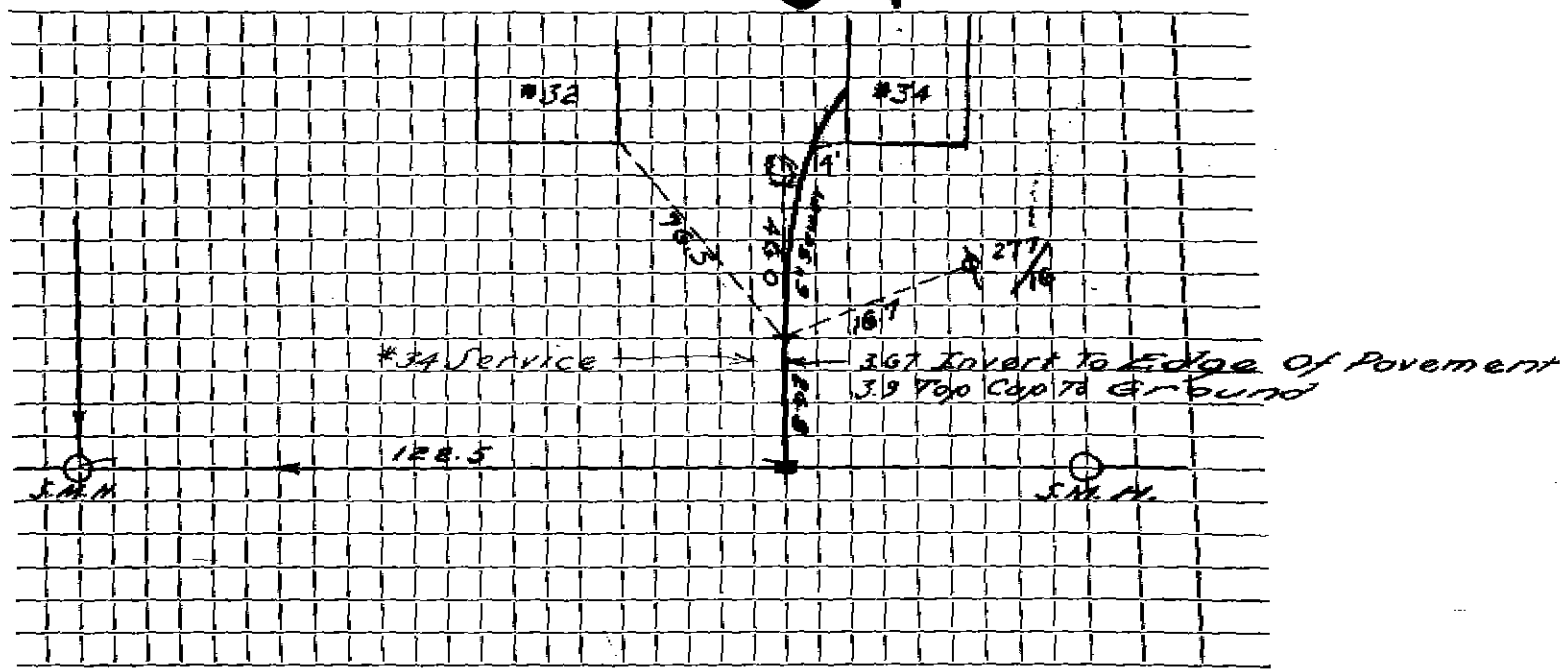

Connection made in Street. Work completed

Remarks:
.....
.....