

Name Philip Gordon

Service No. 183

Address 35 Peacock Farm Road

35 Peacock Farm Rd.

Location 35 Peacock Farm Road

Kind of Pipe

Size 6"

Size of Main 8"

~~Service Renewal~~ - New Service

W 07-8305

Location JUN 9 0 1964


Date	Material	Amount	Total	Date	Amount
-27-63	Labor	103.58		11-12-63	350.00
-2-63	"	34.98		10-13-64	30.00
7-64	"	19.46		1-11-65	80.63
11-64	"	33.96	191.98		430.63
	10% O.H.	19.20	211.18		
	40' 6" Transite pipe @.82		32.80		
	1 bag Cement		1.50		
	10 yds. Loam @2.00		20.00		
	Lime & Fertilizer		1.85		
	3 hrs. Tom Shovel @6.50		19.50		21.8 feet 6" A.C.
	3 hrs. Trucking @3.00		9.00		installed by contractor
	1 hr. Loader @4.00		4.00		@ 6.00 per foot
	Previous Charge		130.80		160.80
			150.80		
			430.63		
			460.63		
					Bill sent 80.63

DATE _____

TOWN OF LEXINGTON — BOARD OF PUBLIC WORKS
SEWER DIVISION

Sketch of Service Here

35

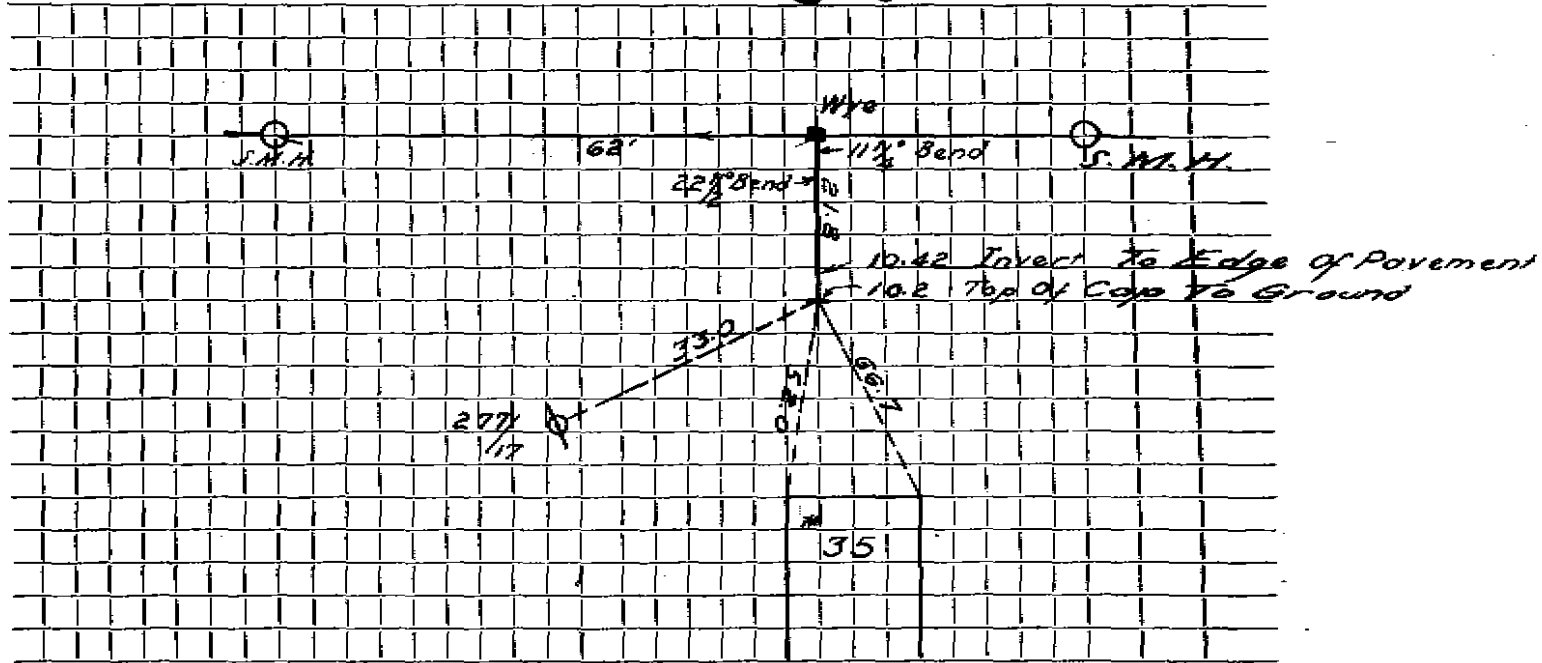

Connection made in Street. Work completed

Remarks:

.....
.....