

Name **George Wolf**

Service No. 185

Address **38 Peacock Farm Road****38 Peacock Farm Rd.**Location **38 Peacock Farm Road**

Kind of Pipe

Size **6"**Size of Main **8"**~~WORK ORDER~~ **New Service****WOLF 8315**

Location

Comm 5-18-64

Date	Material	Amount	Total	Date	Amount	
-13-64	Labor	43.64		11-15-63	Deposit	400.00
-14-64	"	62.34		5-18-64	Retard	29.55
-7-64	"	23.40	129.38			370.45
	10% O.H.	12.94	142.32			
	66' 6" Transite pipe @.82		54.12			
	1 6 x 6 Transite "Y"		4.09			
	1 6" Adapter		1.62			
	3 hrs. Town Shovel @6.50		19.50			
	4 hrs. Trucking @3.00		12.00			
	3 yds. Loan @3.00		9.00		21.3 feet 6" A.C.	
	Previous Charge		127.80		installed by contractor	
			370.45		@ 6.00 per foot	127.80


DATE _____

TOWN OF LEXINGTON — BOARD OF PUBLIC WORKS

SEWER DIVISION

Sketch of Service Here

38

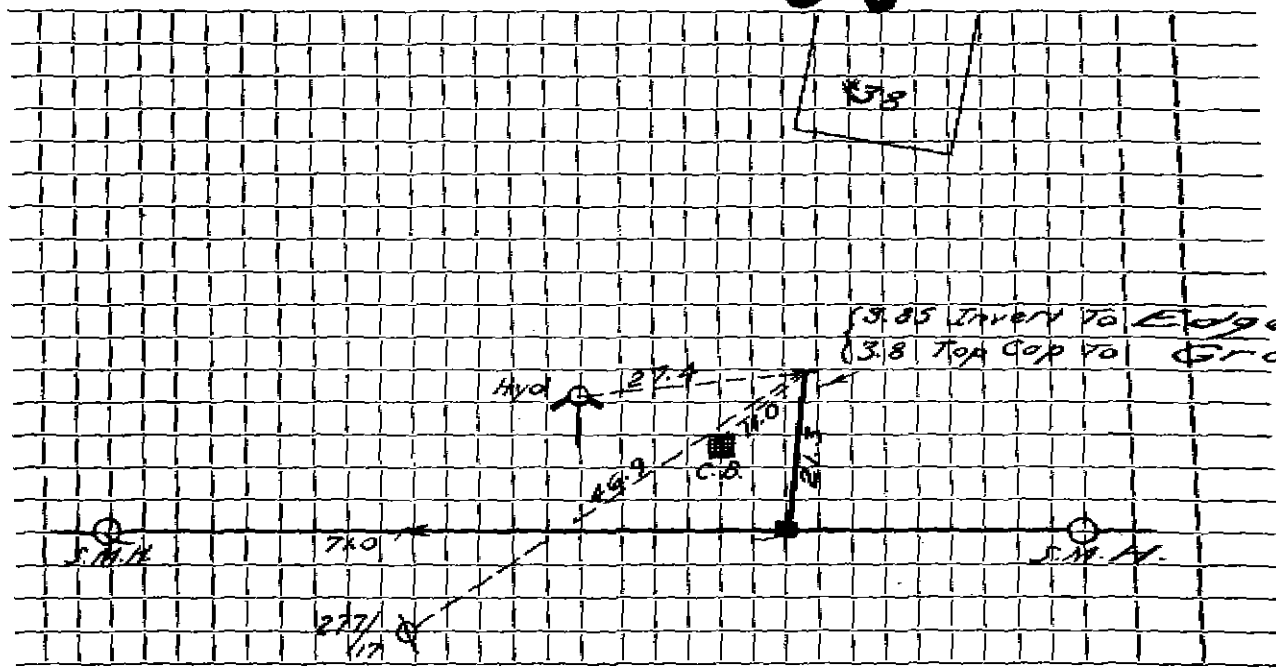

Connection made in Street. Work completed

Remarks:
.....
.....