

Name Fred Wischusen

Service No. 161

Address 39 Peacock Farm Road

39 Peacock Farm Rd.

Location 39 Peacock Farm Road

Kind of Pipe

Size 6"

Size of Main 8"

~~REPAIR WORK~~ - New Service W.O. #9237

Location DEC 28 1964

Date	Material	Amount	Total	Date	Amount
0-19-64	Labor	71.58		9-15-64	585 00
0-20-64	"	27.78		12-28-64	8 55
0-21-64	"	30.97			576 45
0-22-64	"	80.95	211 28		
	10% O.H.	21 13	232 41		
99	6" Sewer Pipe @.82		81 18		
1	Cesspool Cover & Frame		10 50		
3	Bags Cement @1.50		4 50		
2	11 1/2" Bends @4.09		8 18		
2	22 1/2" Bends @4.09		8 18		26.5 feet 6" A.C.
6	Yds. LOam @3.00		18 00		installed by contractor
10	X 3 Patch		10 00		@ 6.00 per foot
5	Hrs. Town Shovel @6.50		32 50		
4	Hrs. Town Truck @3.00		12 00		
	PREVIOUS CHARGE		159 00		
			576 45		


DATE _____

TOWN OF LEXINGTON — BOARD OF PUBLIC WORKS

SEWER DIVISION

Sketch of Service Here

39

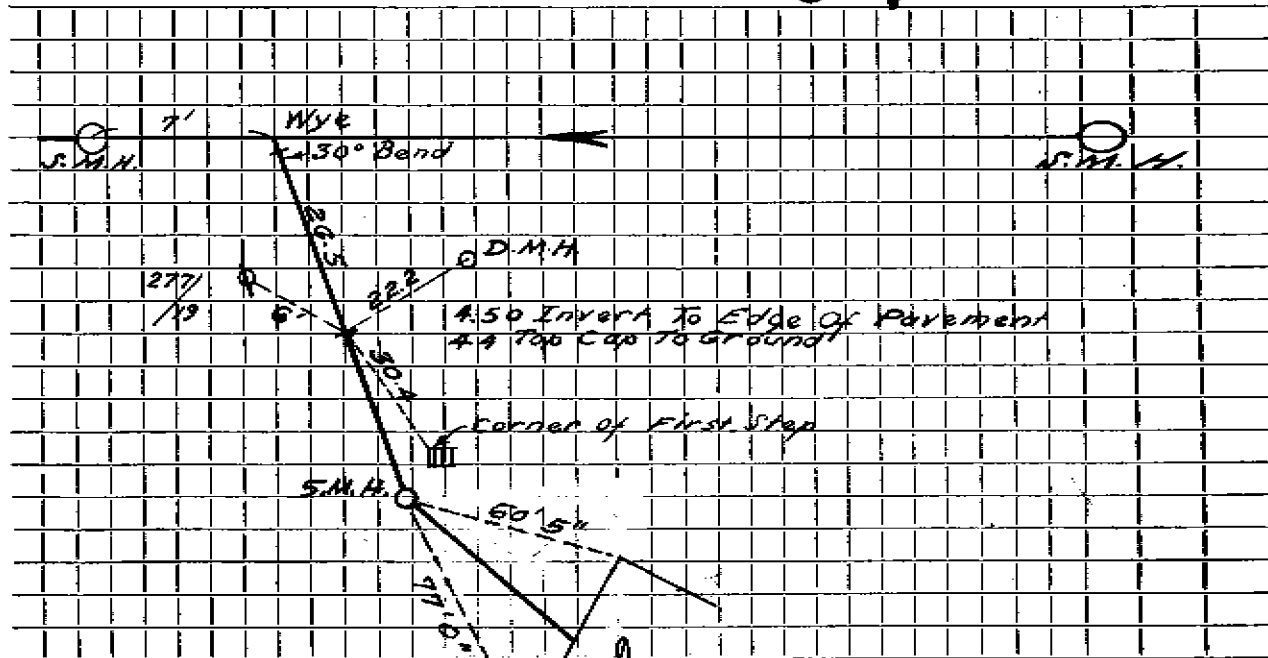

Connection made in Street Work completed

Remarks:

.....

.....