

Name Paul L. Sagalyn

Service No. 207

Address 41 Peacock Farm Road

41 Peacock Farm Rd.

Location 41 Peacock Farm Road

Kind of Pipe

Size 6"

Size of Main 8"

~~REPLACEMENT~~—New Service WOFF 8356

Location 9-21-64

Date	Material	Amount	Total	Date	Amount
-12-61	Previous Charge Labor 80.26		130 80	11-29-63	Deposit 425 00
-13-61	" 46.34			9-30-64	Paid 71 80
-11-61	" 41.51				546 80
-13-61	" 9.44	177 55			
	10% O.H.	17 76	195 31		
	90' 6" Transite pipe @ .82		73 80		NON-CHARGE
	1 20" Cesspool cover & Frame		10 50	2-10-64	Labor 86.42
	4 Bags Cement @ 1.50		6 00	2-11-64	" 80.26
	500 Sewer Brick @ 4.20 per 100		21 00		
	3 Ton Sand @ 1.10		3 30		21.8 feet 6" A.C.
	1 11 1/4" Transite bend		4 09		installed by contractor
	8 Yds Loam @ 3.00		24 00		@ 6.00 per foot
	6 Hrs Trucking @ 3.00		18 00		
	3 Hrs Compressor @ 5.00		15 00		
	7 Hrs Tom Shovel @ 6.50		45 00		
			<u>546 80</u>		Bill sent 71 80


DATE _____

TOWN OF LEXINGTON — BOARD OF PUBLIC WORKS

SEWER DIVISION

Sketch of Service Here

41

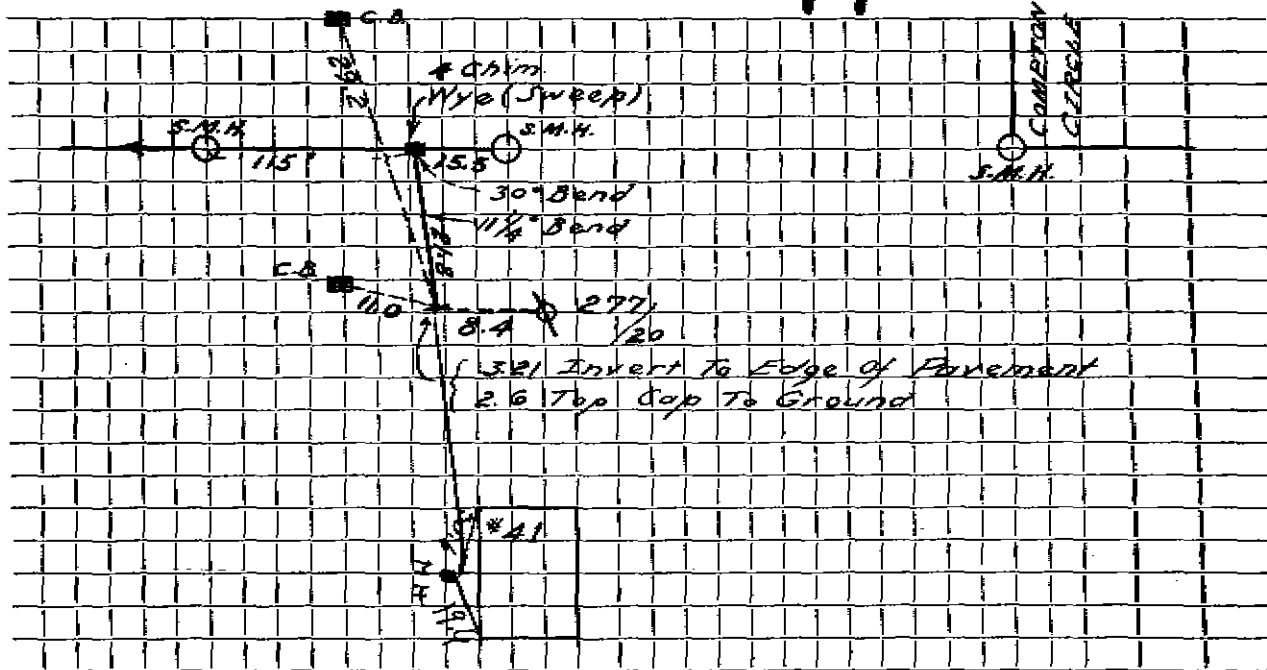

Connection made in Street. Work completed

Remarks:

.....

.....